


V:\953\active\9530002\transportation\drawing\contract_3\plot_files\zd307c3xs_east.prf

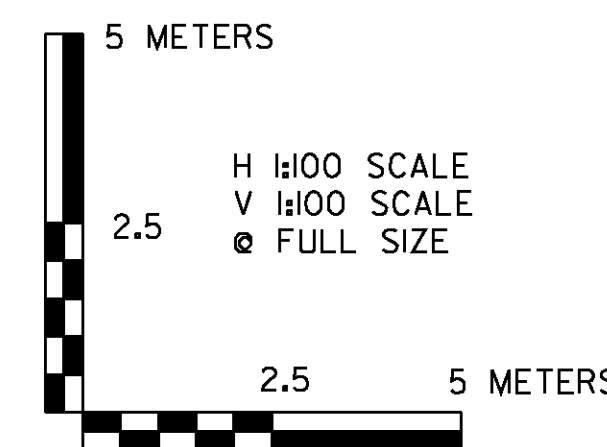

VERMONT AGENCY OF TRANSPORTATION	
	PROJECT NAME: BENNINGTON
	PROJECT NUMBER: AC NH 019-1(53)
DESIGN SUPERVISOR: GREG EDWARDS	DESIGNED BY: MARC FOISY
FILE NAME: ...\plot_files\zd307c3xs_east.prf	PLOT DATE: 5/16/2011
EAST ROAD CROSS SECTIONS	DRAWN BY: STANTEC CHECKED BY: GARY SANTY SHEET 347 OF 577