

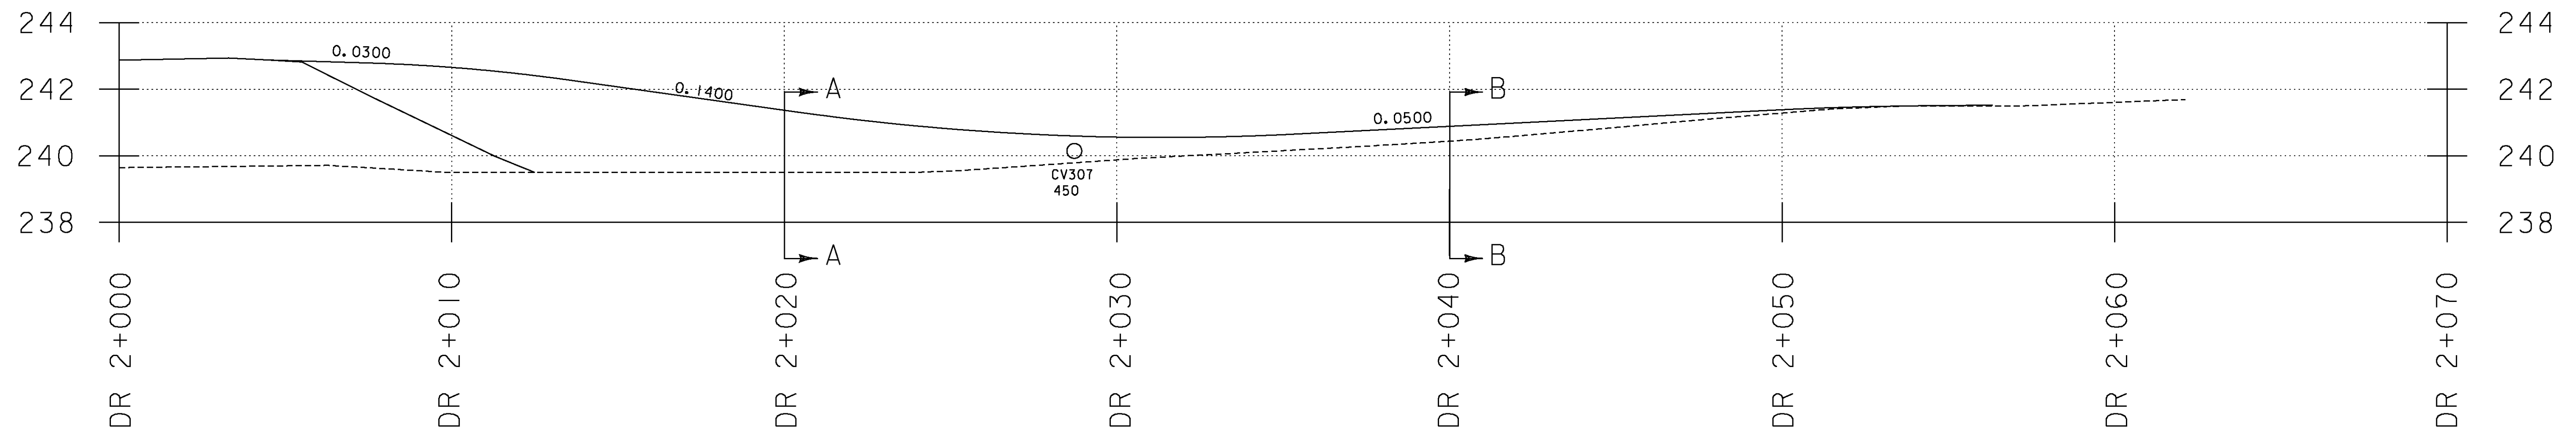
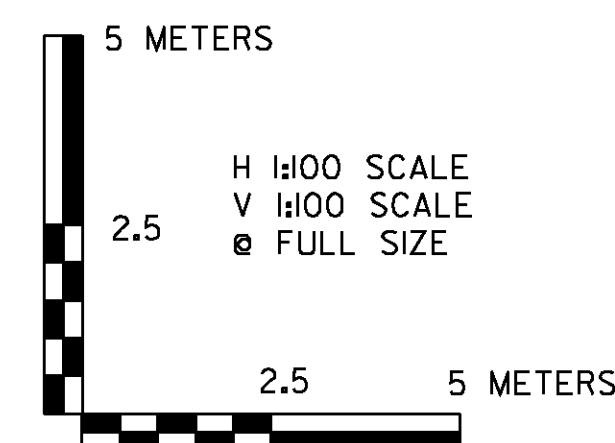


EAST ROAD 1+107 DRIVE

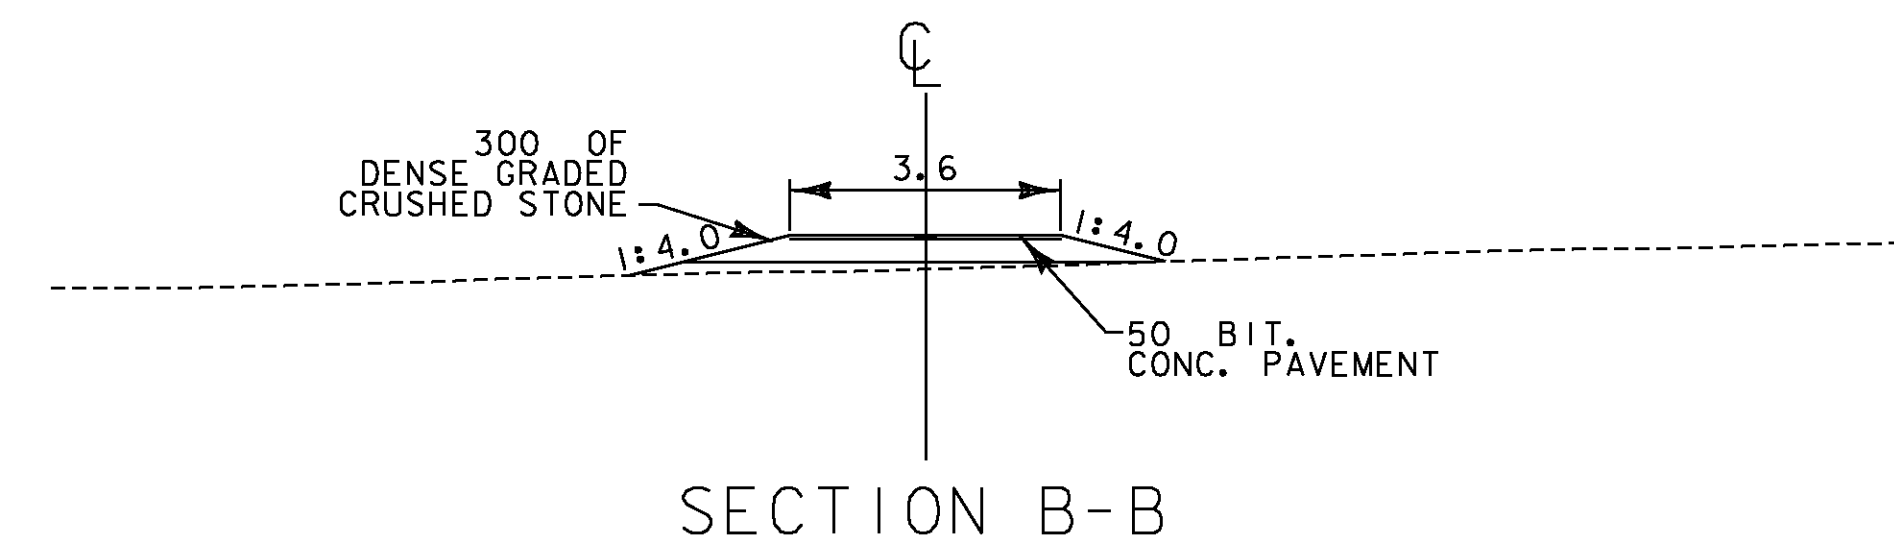

PROFILE

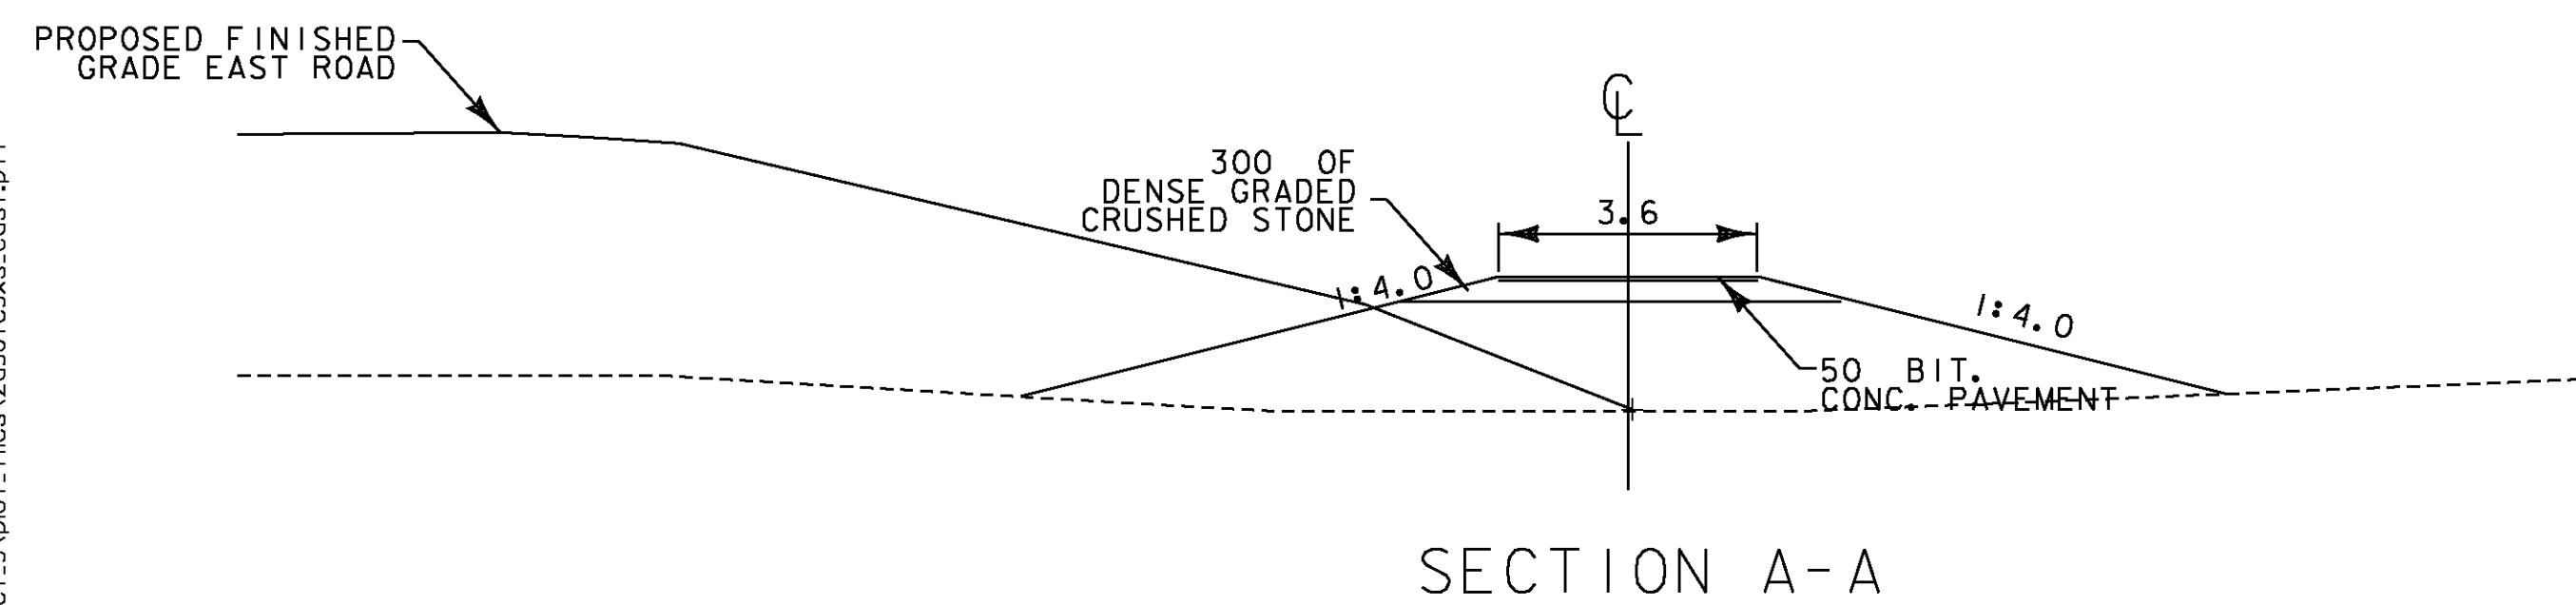

VERMONT AGENCY OF TRANSPORTATION



PROJECT NAME: BENNINGTON
PROJECT NUMBER: AC NH 019-(153)

FILE NAME: ...\\plot_files\zd307c3xs.east.ptf PLOT DATE: 5/16/2011
DESIGN SUPERVISOR: GREG EDWARDS DRAWN BY: STANTEC
DESIGNED BY: MARC FOISY CHECKED BY: GARY SANTY
EAST ROAD 1+107 DRIVE SHEET 361 OF 577

V:\953\active\9530002A\transportation\drawing\contract_3\plot_files\zd307c3xs.east.ptf