



G 1+460

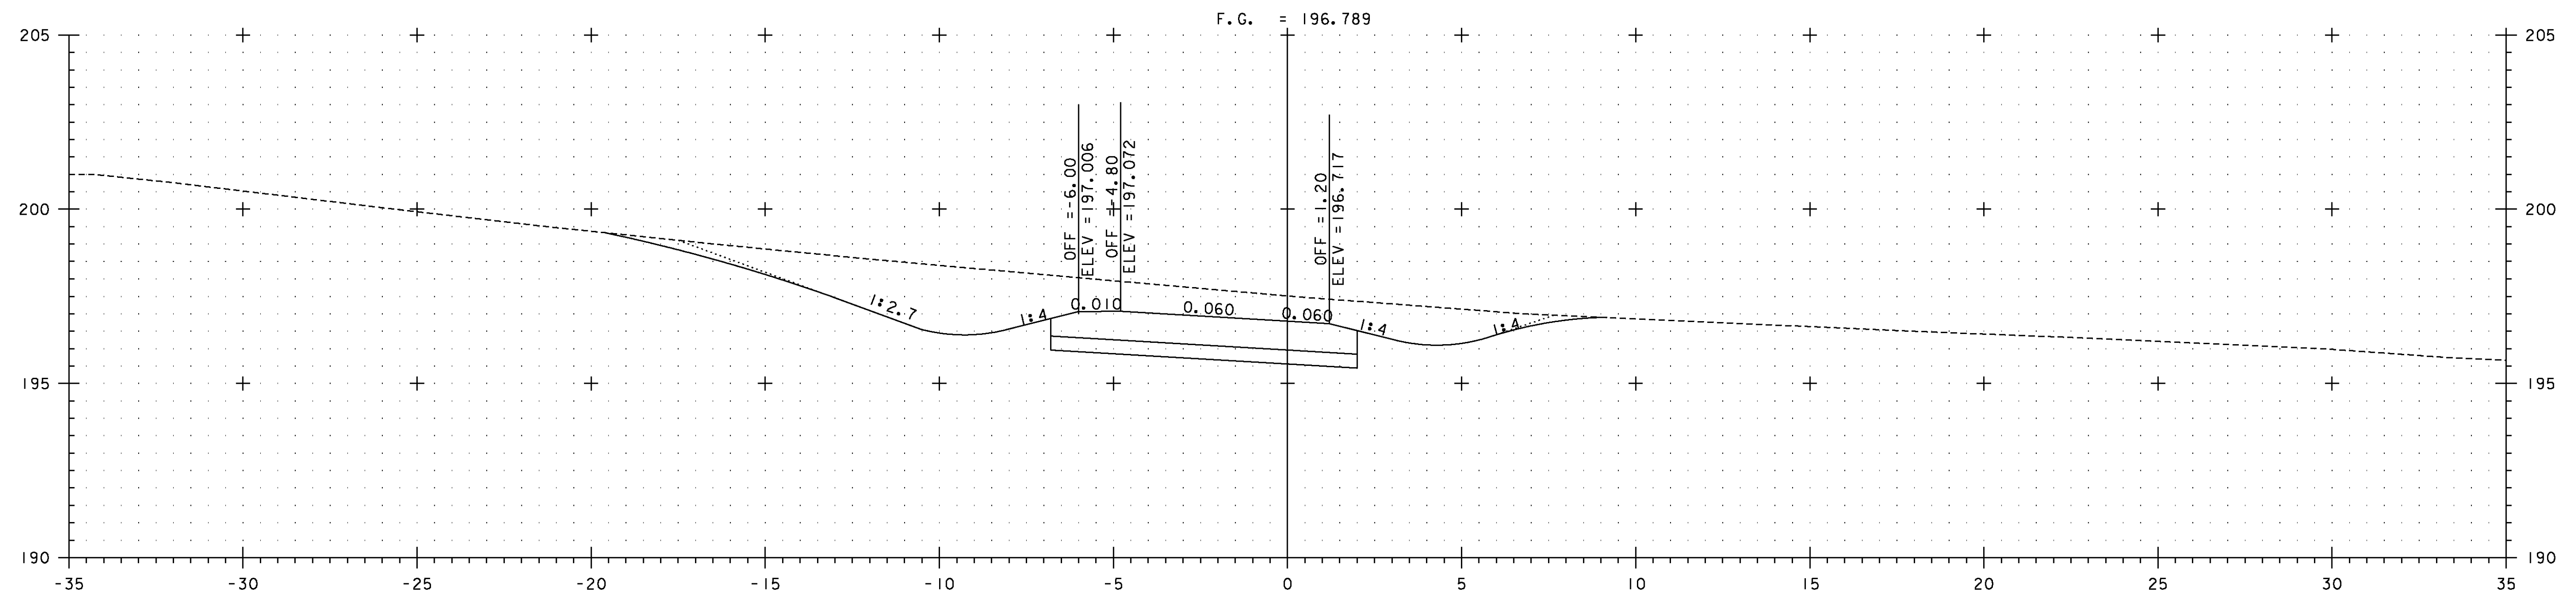

G 1+440

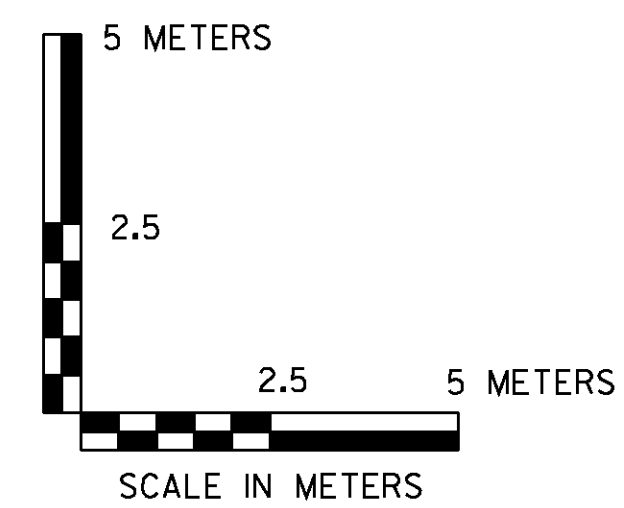

**VERMONT AGENCY OF TRANSPORTATION**



PROJECT NAME: BENNINGTON  
PROJECT NUMBER: AC NH 019-(153)

FILE NAME: ...\\zd307c3xs\_ramp\_g.ptf  
DESIGN SUPERVISOR: GREG EDWARDS  
DESIGNED BY: MARC FOISY  
**RAMP G CROSS SECTIONS**

PLOT DATE: 5/16/2011  
DRAWN BY: STANTEC  
CHECKED BY: GARY SANTY  
SHEET 366 OF 577