



G 1+540 UNDERCUT AND TYPE II STONE FILL
BEGINS AT G 1+530

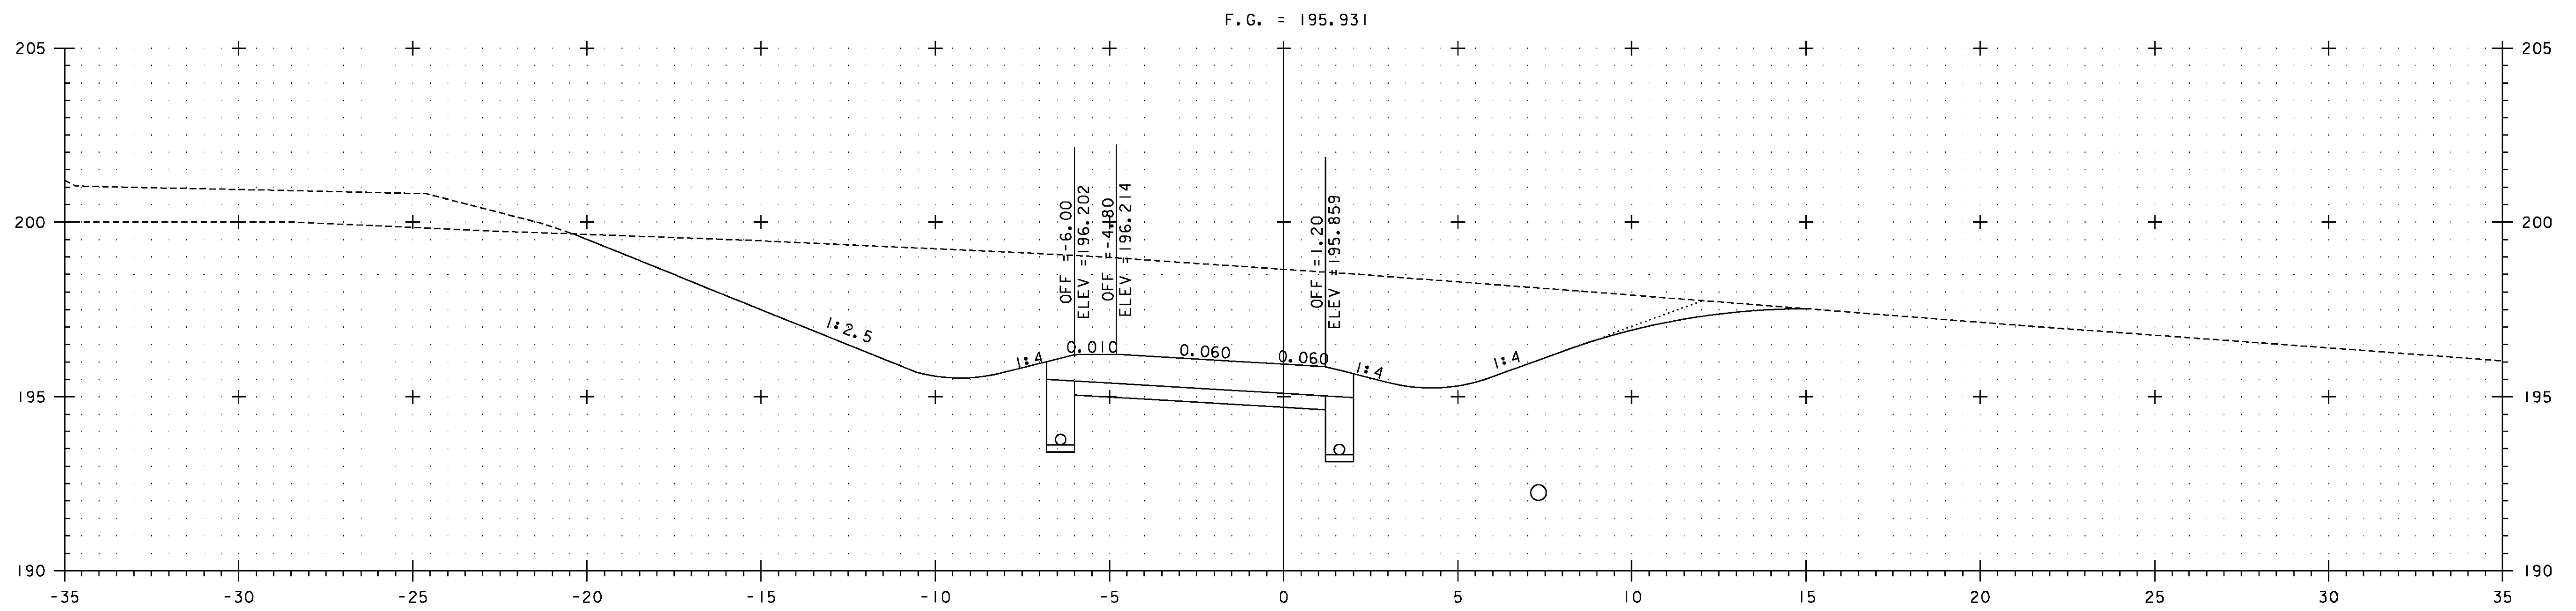

G 1+520

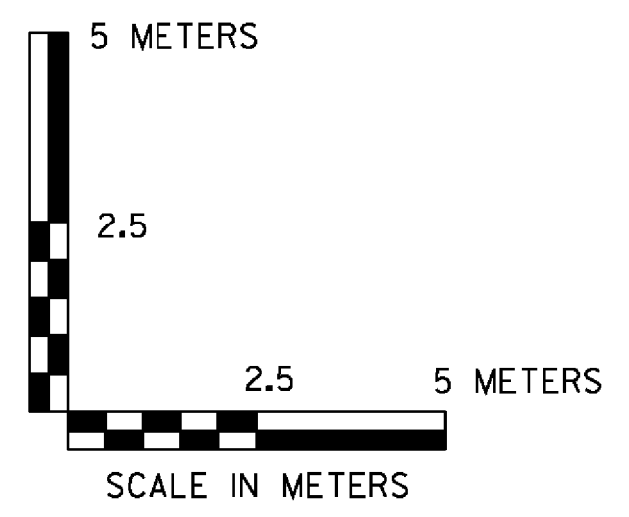

VERMONT AGENCY OF TRANSPORTATION	
	PROJECT NAME: BENNINGTON PROJECT NUMBER: AC NH 019-1(53)
FILE NAME: ...vzd307c3xs_ramp.gptf DESIGN SUPERVISOR: GREG EDWARDS DESIGNED BY: MARC FOISY RAMP G CROSS SECTIONS	PLOT DATE: 5/16/2011 DRAWN BY: STANTEC CHECKED BY: GARY SANTY SHEET 368 OF 577

v:\953\active\9530002\transportation\drawing\contract\3\plot_files\vzd307c3xs_ramp.gptf