


G 1+700

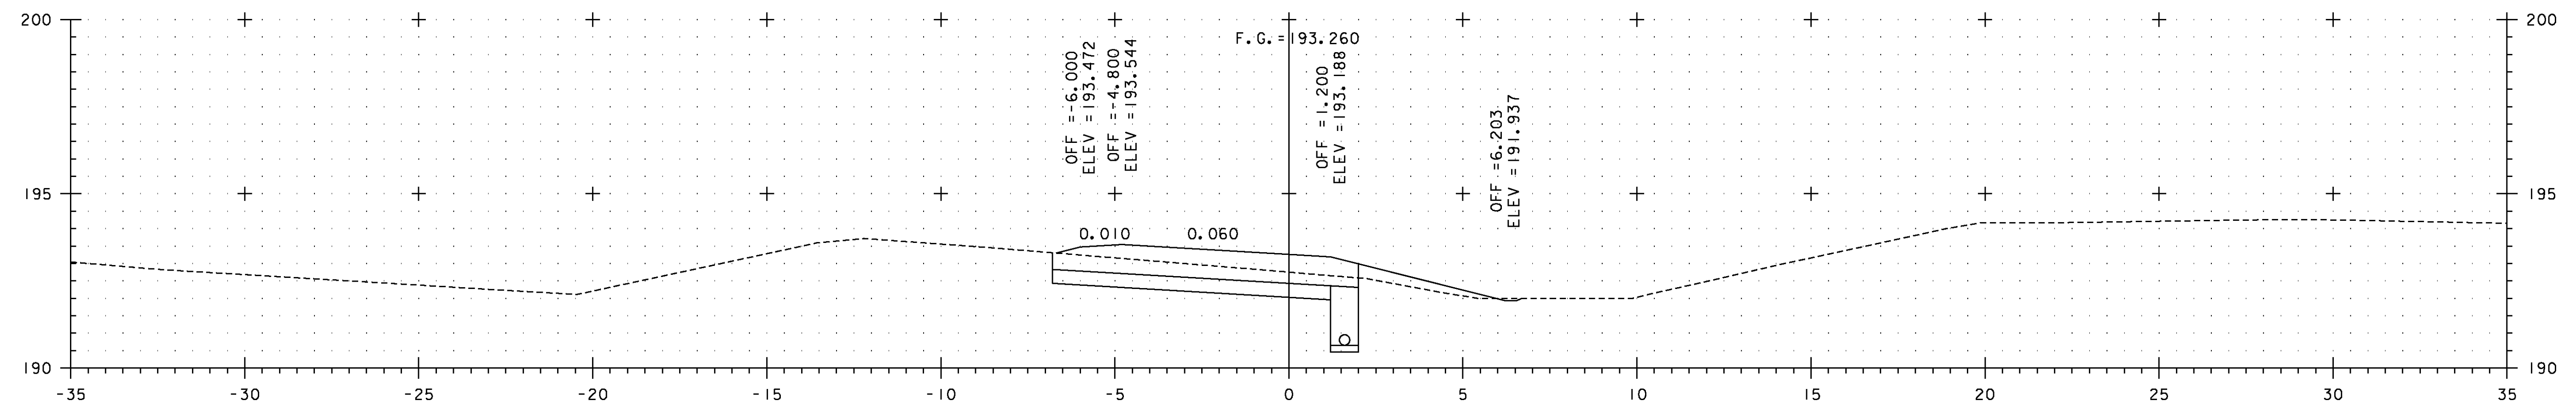

G 1+680

V:\953\active\9530002\transportation\drawing\contract_3\plot_files\zd307c3xs_ramp.gptf

VERMONT AGENCY OF TRANSPORTATION



PROJECT NAME: BENNINGTON
PROJECT NUMBER: AC NH 019-(153)

FILE NAME: ...\\zd307c3xs_ramp.gptf PLOT DATE: 5/16/2011
DESIGN SUPERVISOR: GREG EDWARDS DRAWN BY: STANTEC
DESIGNED BY: MARC FOISY CHECKED BY: GARY SANTY
RAMP G CROSS SECTIONS SHEET 372 OF 577