


SI 1+020

EMBANKMENTS AT THE SYSTEMS INTERCHANGE, AS INDICATED ON PLAN SHEETS 373 THROUGH 383, WERE NOT CONSTRUCTED AS INDICATED ON THESE SHEETS. DURING THE COURSE OF THE CONTRACT, EXCESS MATERIAL WAS PLACED IN THESE AREAS ABOVE THE GRADES INDICATED, BY CHANGE OF DESIGN #20 AND WRITTEN ORDER #97, APPROXIMATELY HALF OF THE EXCESS MATERIAL WAS REMOVED AND PLACED IN ANOTHER AREA AS APPROVED. THE STATE AND THE CONTRACTOR AGREED THAT THE OTHER HALF (APPROX) OF THE EXCESS MATERIAL WOULD BE REMOVED UNDER CONTRACT 54.

ALSO SEE BOX 3 OF 15 OF THE CONTRACT RECORDS- IN A BINDER LABELED MISCELLANEOUS COMPUTATIONS-FOR SOME PERTINENT CROSS SECTIONS.

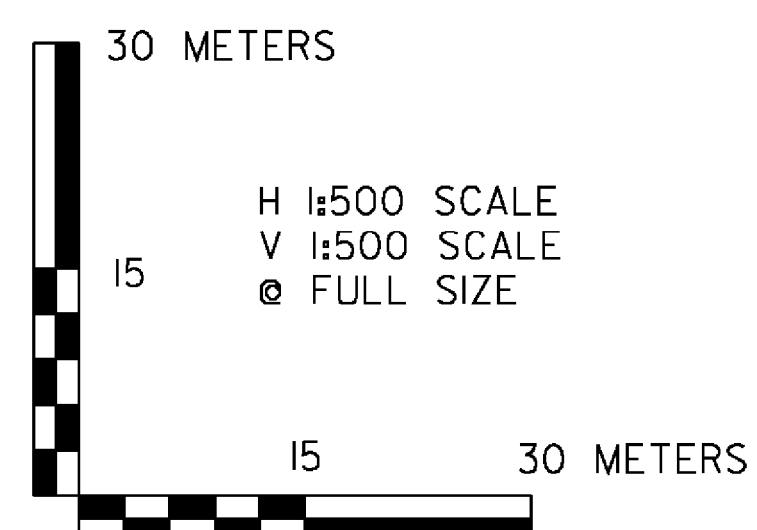

VERMONT AGENCY OF TRANSPORTATION



PROJECT NAME: BENNINGTON  
PROJECT NUMBER: AC NH 019-1(53)

FILE NAME: ... \zd307c3xs\_sl\_fill.ptf  
DESIGN SUPERVISOR: GREG EDWARDS  
DESIGNED BY: MARC FOISY  
WC WASTE SITE - 3

PLOT DATE: 5/16/2011  
DRAWN BY: STANTEC  
CHECKED BY: GARY SANTY  
SHEET 373 OF 577