


SEE NOTE
ON
SHEET 373



VERMONT AGENCY OF TRANSPORTATION

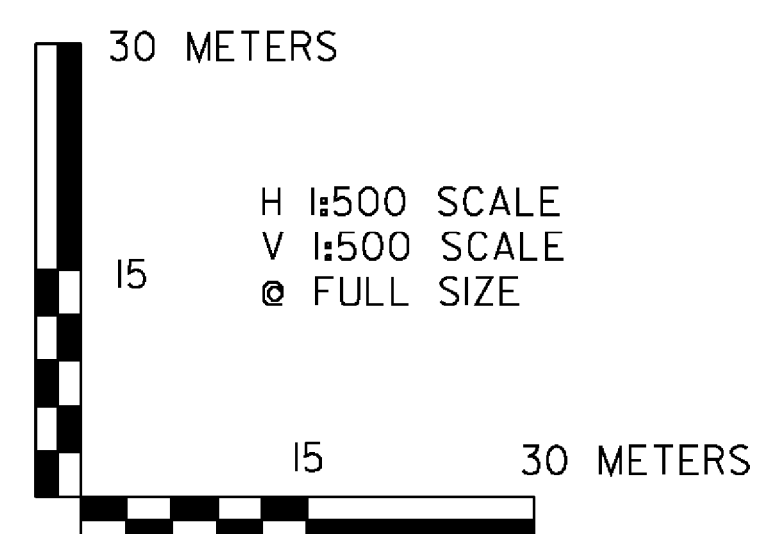

PROJECT NAME: BENNINGTON
PROJECT NUMBER: AC NH 019-1(53)

FILE NAME: ...vzd307c3xs_sl_fill.plt
DESIGN SUPERVISOR: GREG EDWARDS
DESIGNED BY: MARC FOISY
WC WASTE SITE - 5

PLOT DATE: 5/16/2011
DRAWN BY: STANTEC
CHECKED BY: GARY SANTY
SHEET 375 OF 577