


SI 1+120

SEE NOTE  
ON  
SHEET 373



**VERMONT AGENCY OF TRANSPORTATION**

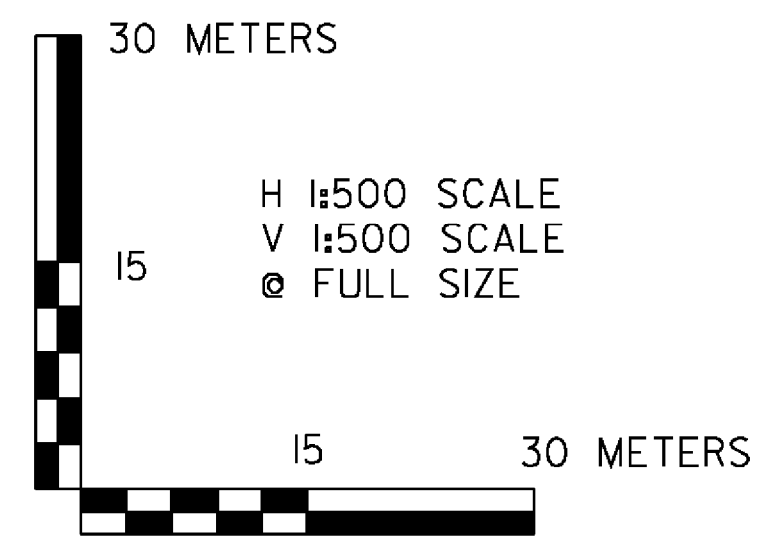

PROJECT NAME:	BENNINGTON
PROJECT NUMBER:	AC NH 019-1(53)
FILE NAME: ...vzd307c3xs_sl_flll.pff	PLOT DATE: 5/16/2011
DESIGN SUPERVISOR: GREG EDWARDS	DRAWN BY: STANTEC
DESIGNED BY: MARC FOISY	CHECKED BY: GARY SANTY
<b>WC WASTE SITE - 6</b>	SHEET 376 OF 577

w:\953\active\9530002\transportation\drawing\contract\_3\plot\_files\zcd307c3xs\_sl\_flll.pff