


SI 1+140

SEE NOTE
ON
SHEET 373



VERMONT AGENCY OF TRANSPORTATION

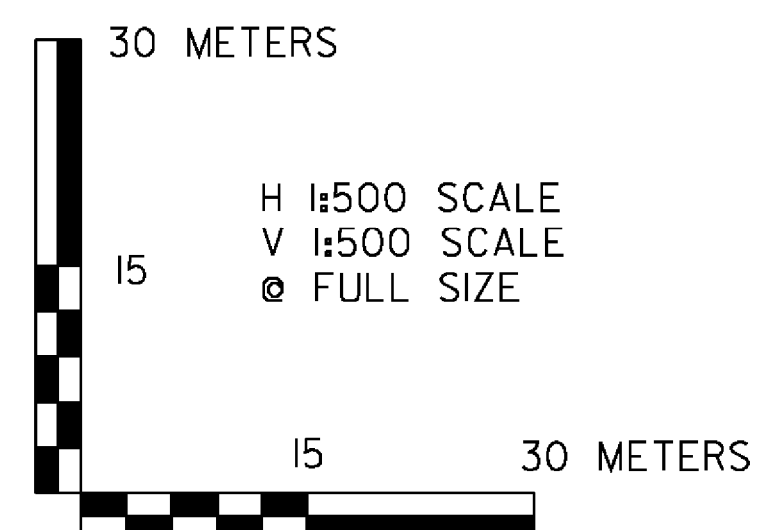

PROJECT NAME:	BENNINGTON
PROJECT NUMBER:	AC NH 019-1(53)
FILE NAME:	...z307c3xs_sl_flll.pff
DESIGN SUPERVISOR:	GREG EDWARDS
DESIGNED BY:	MARC FOISY
WC WASTE SITE - 7	
PLOT DATE:	5/16/2011
DRAWN BY:	STANTEC
CHECKED BY:	GARY SANTY
SHEET	377 OF 577

w:\953\active\9530002\transportation\drawing\contract_3\plot_files\z307c3xs_sl_flll.pff