


SI 1+160

SEE NOTE  
ON  
SHEET 373



**VERMONT AGENCY OF TRANSPORTATION**

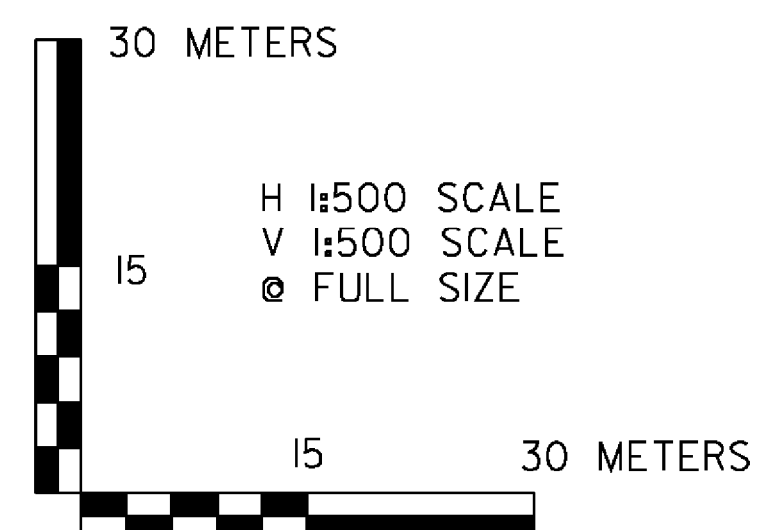

PROJECT NAME:	BENNINGTON
PROJECT NUMBER:	AC NH 019-1(53)
FILE NAME:	...vzd307c3xs_sl_fill.prf
DESIGN SUPERVISOR:	GREG EDWARDS
DESIGNED BY:	MARC FOISY
WC WASTE SITE - 8	
PLOT DATE:	5/16/2011
DRAWN BY:	STANTEC
CHECKED BY:	GARY SANTY
	SHEET 378 OF 577

w:\953\active\9530002\transportation\drawing\contract\_3\plot\_files\zcd307c3xs\_sl\_fill.prf