



SI 1+260

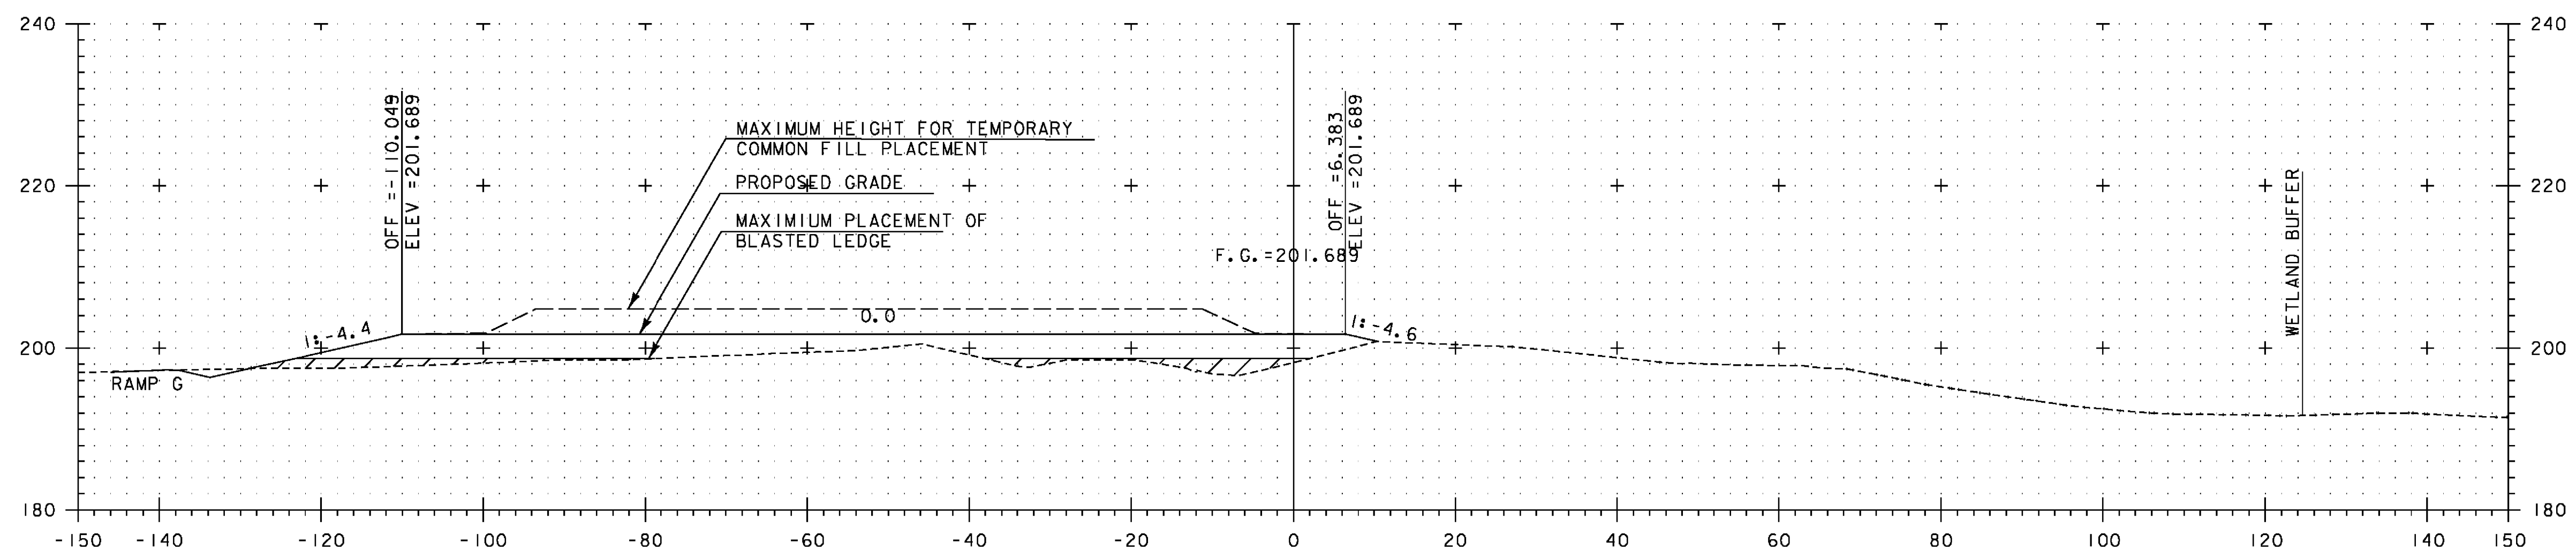

SI 1+240

SEE NOTE  
ON  
SHEET 373

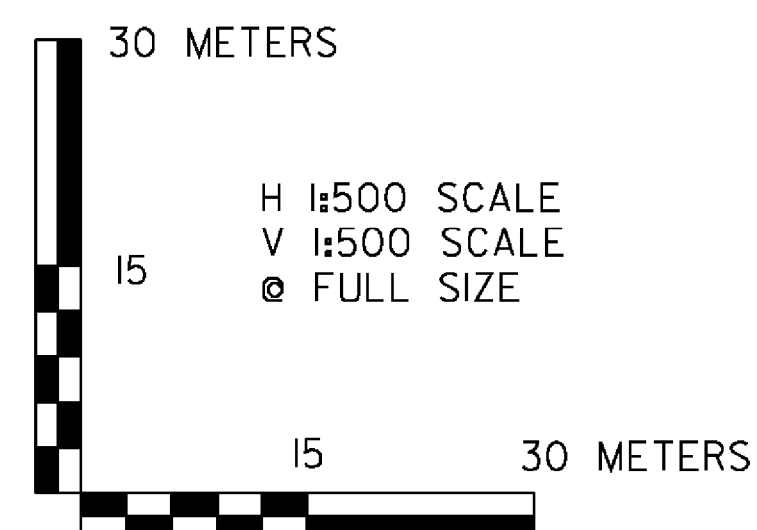

VERMONT AGENCY OF TRANSPORTATION



PROJECT NAME: BENNINGTON  
PROJECT NUMBER: AC NH 019-1(53)

FILE NAME: ...vzd307c3xs\_sl\_fill.pfl PLOT DATE: 5/16/2011  
DESIGN SUPERVISOR: GREG EDWARDS DRAWN BY: STANTEC  
DESIGNED BY: MARC FOISY CHECKED BY: GARY SANTY  
WC WASTE SITE - 11 SHEET 381 OF 577