


SW 3+000

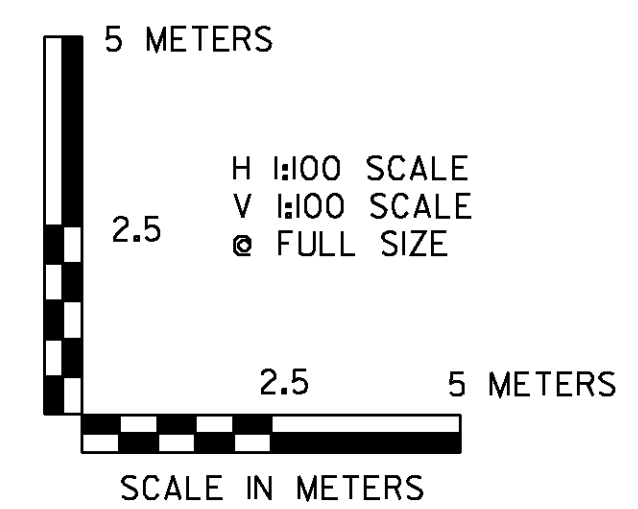

VERMONT AGENCY OF TRANSPORTATION	
	PROJECT NAME: BENNINGTON
	PROJECT NUMBER: AC NH 019-(153)
	FILE NAME: ...\plot_files\zd307c3xs_sw.pxf
	PLOT DATE: 5/16/2011
DESIGN SUPERVISOR: GREG EDWARDS	DRAWN BY: STANTEC
DESIGNED BY: MARC FOISY	CHECKED BY: GARY SANTY
SWALE 3 CROSS SECTIONS	SHEET 384 OF 577

V:\9513\active\95130002\transportation\drawing\contract_3\plot_files\zd307c3xs_sw.pxf