


SW 3+020

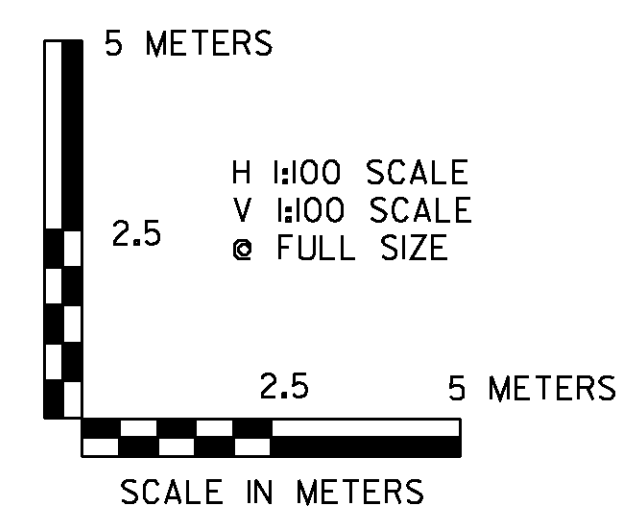

VERMONT AGENCY OF TRANSPORTATION	
	PROJECT NAME: BENNINGTON
	PROJECT NUMBER: AC NH 019-1(53)
	FILE NAME: ...\plot_files\zd307c3xs_sw.pft
	DESIGN SUPERVISOR: GREG EDWARDS
DESIGNED BY: MARC FOISY	PLOT DATE: 5/16/2011
SWALE 3 CROSS SECTIONS	DRAWN BY: STANTEC
	CHECKED BY: GARY SANTY
	SHEET 385 OF 577

v:\9513\active\95130002\transportation\drawing\contract_3\plot_files\zd307c3xs_sw.pft