


SW 3+040

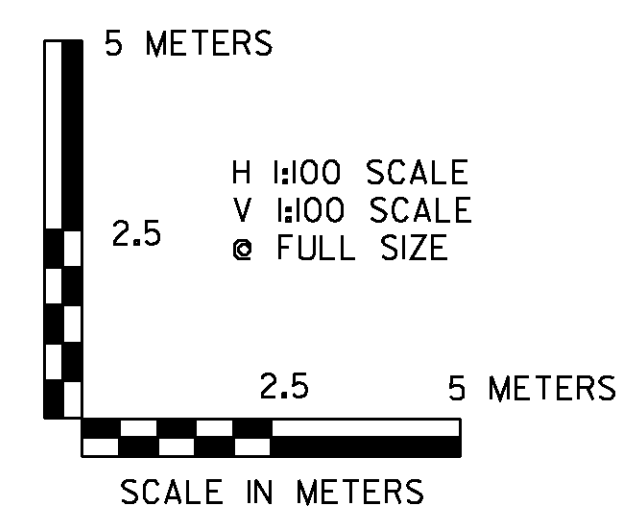

<b>VERMONT AGENCY OF TRANSPORTATION</b>	
	PROJECT NAME: BENNINGTON
	PROJECT NUMBER: AC NH 019-1(53)
	FILE NAME: ...\\plot_files\zd307c3xs_sw.p1f
	DESIGN SUPERVISOR: GREG EDWARDS
DESIGNED BY: MARC FOISY	PLOT DATE: 5/16/2011
<b>SWALE 3 CROSS SECTIONS</b>	DRAWN BY: STANTEC
	CHECKED BY: GARY SANTY
	SHEET 386 OF 577

v:\9513\active\95130002\transportation\drawing\contract\_3\plot\_files\zd307c3xs\_sw.p1f