


SW 3+080

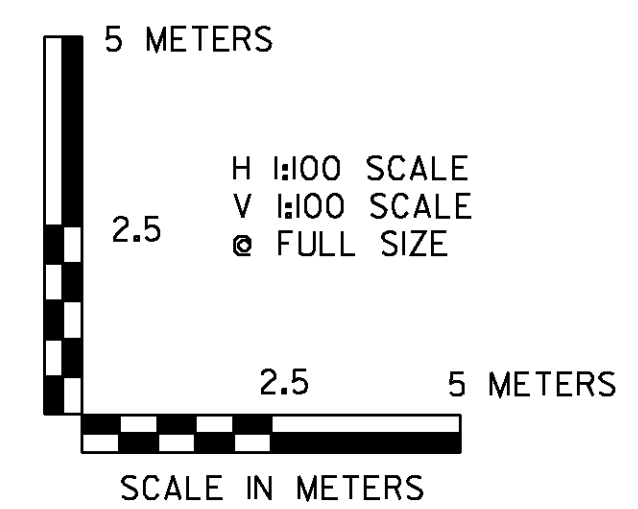

VERMONT AGENCY OF TRANSPORTATION	
	PROJECT NAME: BENNINGTON
	PROJECT NUMBER: AC NH 019-(153)
	FILE NAME: ...\\plot_files\zd307c3xs_sw.pft
	DESIGN SUPERVISOR: GREG EDWARDS
DESIGNED BY: MARC FOISY	PLOT DATE: 5/16/2011
SWALE 3 CROSS SECTIONS	DRAWN BY: STANTEC
	CHECKED BY: GARY SANTY
	SHEET 388 OF 577

V:\953\active\9530002\transportation\drawing\contract_3\plot_files\zd307c3xs_sw.pft