


SW 3+100

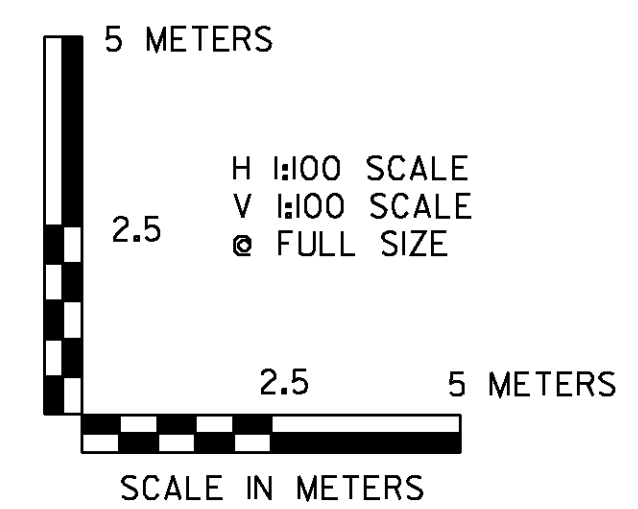

<b>VERMONT AGENCY OF TRANSPORTATION</b>	
	PROJECT NAME: BENNINGTON PROJECT NUMBER: AC NH 019-1(53)
	FILE NAME: ...\plot_files\zd307c3xs_sw.p1f DESIGN SUPERVISOR: GREG EDWARDS DESIGNED BY: MARC FOISY <b>SWALE 3 CROSS SECTIONS</b>

V:\9513\active\95130002\transportation\drawing\contract\_3\plot\_files\zd307c3xs\_sw.p1f