


SW 3+120

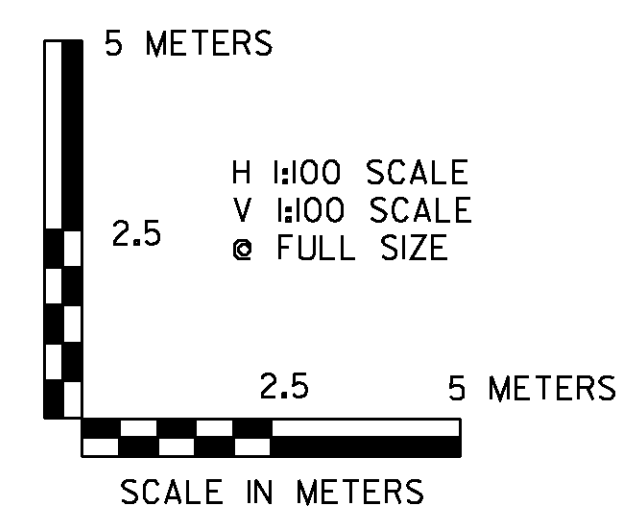

VERMONT AGENCY OF TRANSPORTATION	
	PROJECT NAME: BENNINGTON
	PROJECT NUMBER: AC NH 019-1(53)
	FILE NAME: ...\plot_files\zd307c3xs_sw.p1f
DESIGN SUPERVISOR: GREG EDWARDS	PLOT DATE: 5/16/2011
DESIGNED BY: MARC FOISY	DRAWN BY: STANTEC
SWALE 3 CROSS SECTIONS	CHECKED BY: GARY SANTY
	SHEET 390 OF 577

v:\9513\active\95130002\transportation\drawing\contract_3\plot_files\zd307c3xs_sw.p1f