


SW 3+140

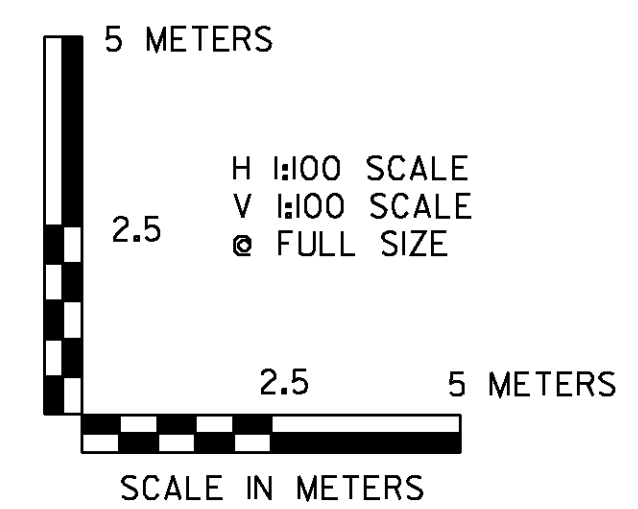

|   |  |
|---|--|
| <b>VERMONT AGENCY OF TRANSPORTATION</b> |  |
|   | PROJECT NAME: BENNINGTON                   |
|   | PROJECT NUMBER: AC NH 019-(153)            |
|   | FILE NAME: ...\plot_files\zd307c3xs_sw.pft |
|   | SWALE 3 CROSS SECTIONS                     |
|   | PLOT DATE: 5/16/2011                       |
|   | DRAWN BY: STANTEC                          |
|   | CHECKED BY: GARY SANTY                     |
|   | SHEET 391 OF 577                           |

V:\9513\active\95130002\transportation\drawing\contract\_3\plot\_files\zd307c3xs\_sw.pft