


V:\953\active\9530002A\transportation\drawing\contract\_3\plot\_files\zd307c3xs\_sw.pft

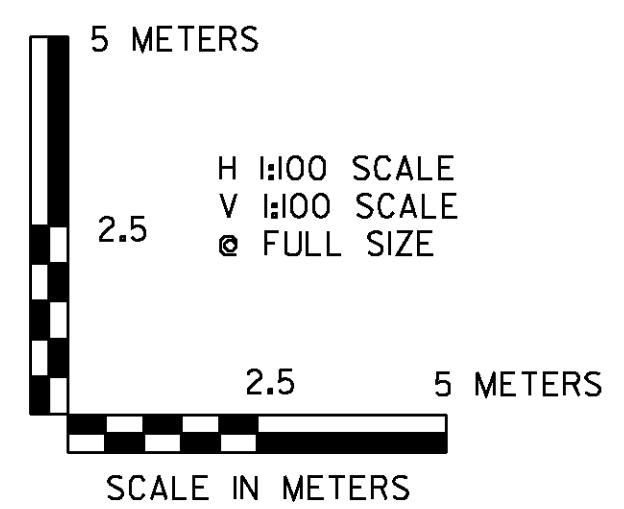

<b>VERMONT AGENCY OF TRANSPORTATION</b>	
	PROJECT NAME: BENNINGTON
	PROJECT NUMBER: AC NH 019-(153)
FILE NAME: ...\plot_files\zd307c3xs_sw.pft	PLOT DATE: 5/16/2011
DESIGN SUPERVISOR: GREG EDWARDS	DRAWN BY: STANTEC
DESIGNED BY: MARC FOISY	CHECKED BY: GARY SANTY
<b>SWALE 3 CROSS SECTIONS</b>	SHEET 395 OF 577