



SW 3+280

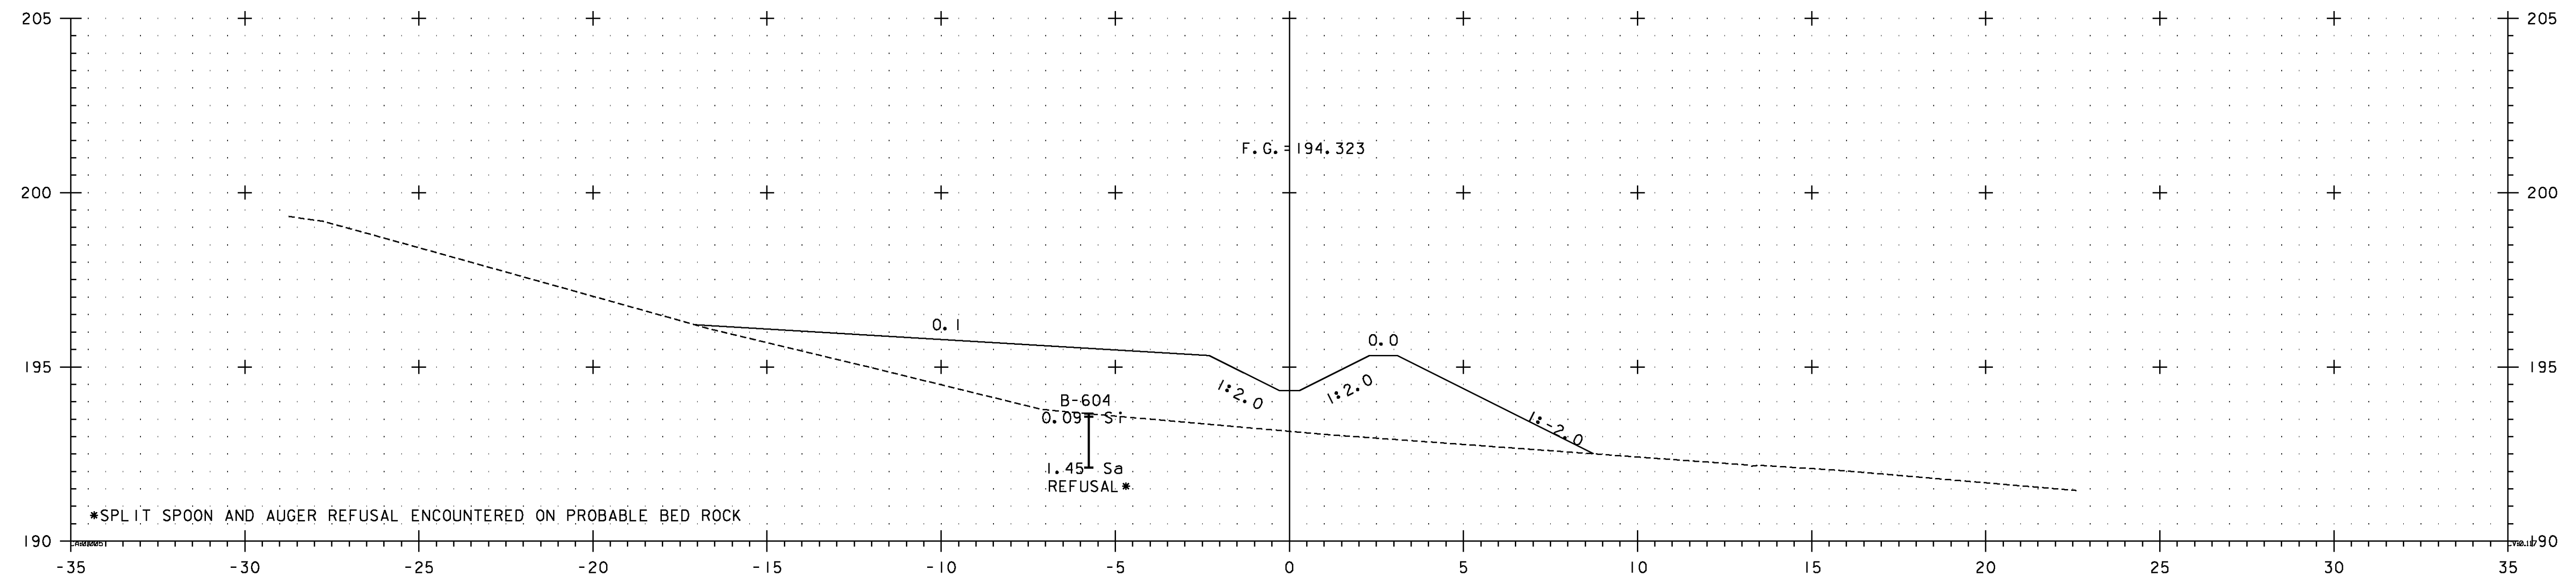

SW 3+260

*SPLIT SPOON AND AUGER REFUSAL ENCOUNTERED ON PROBABLE BED ROCK

B-604
0.09' S.F.
1.45' Sa
REFUSAL*

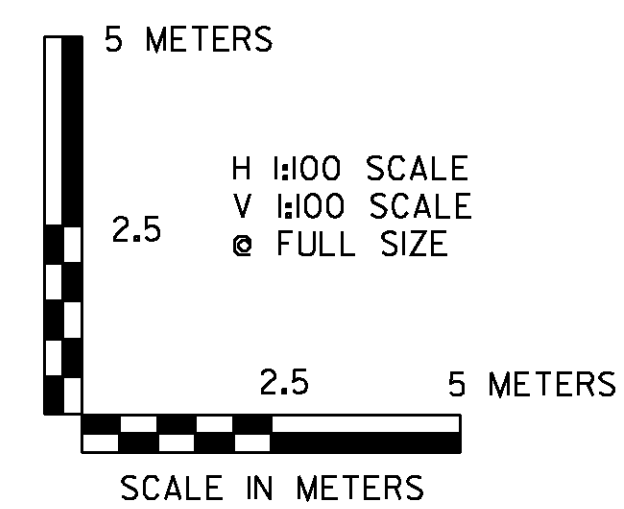

VERMONT AGENCY OF TRANSPORTATION	
	PROJECT NAME: BENNINGTON PROJECT NUMBER: AC NH 019-1(53)
	FILE NAME: ...\plot_files\zd307c3xs_sw.p1f DESIGN SUPERVISOR: GREG EDWARDS DESIGNED BY: MARC FOISY SWALE 3 CROSS SECTIONS

V:\9513\active\95130002\transportation\drawing\contract_3\plot_files\zd307c3xs_sw.p1f