



SW 3+320

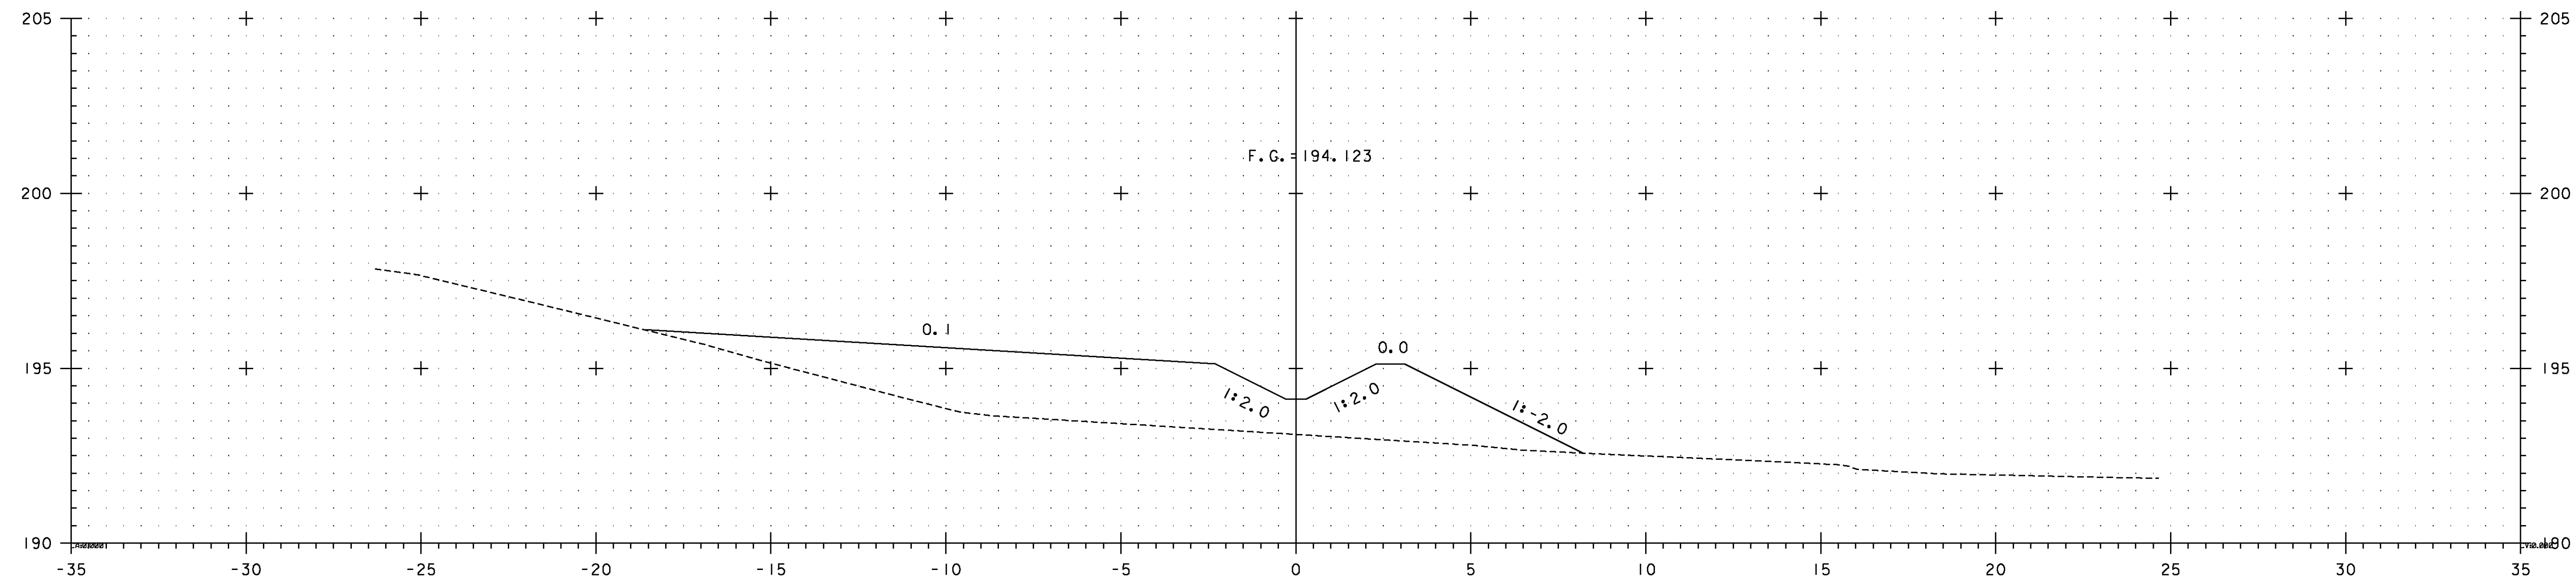

SW 3+300

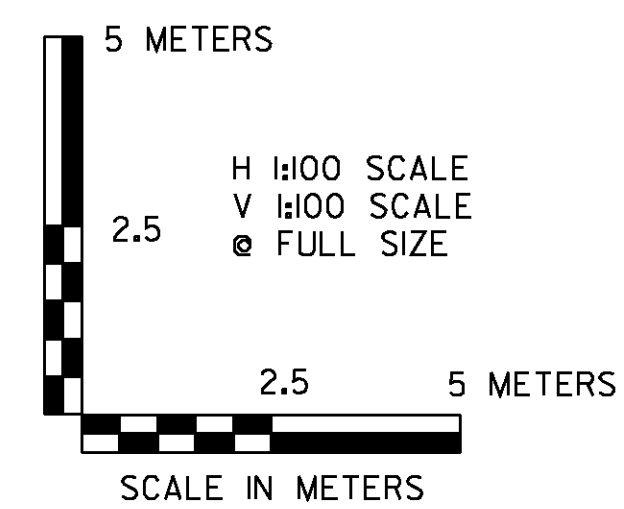

VERMONT AGENCY OF TRANSPORTATION



PROJECT NAME: BENNINGTON
PROJECT NUMBER: AC NH 019-1(53)

FILE NAME: ...\\plot_files\zd307c3xs_sw.pft PLOT DATE: 5/16/2011
DESIGN SUPERVISOR: GREG EDWARDS DRAWN BY: STANTEC
DESIGNED BY: MARC FOISY CHECKED BY: GARY SANTY
SWALE 3 CROSS SECTIONS SHEET 397 OF 577

V:\9513\active\95130002\transportation\drawing\contract_3\plot_files\zd307c3xs_sw.pft