


V:\953\active\9530002\Transportation\drawing\contract_3\plot_files\zd307c3xs_ramp.dwg

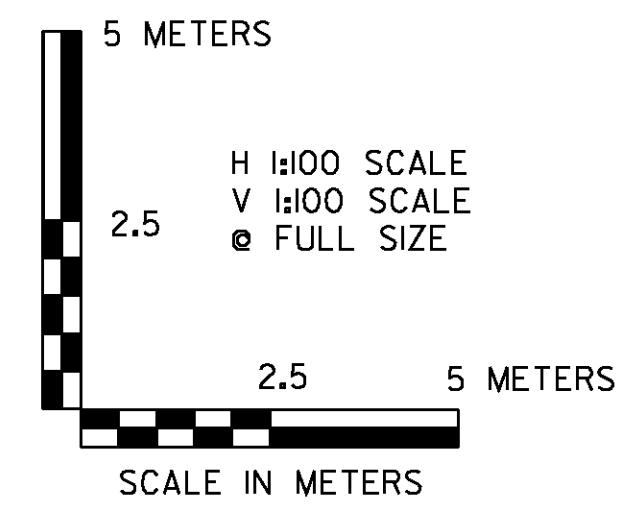

VERMONT AGENCY OF TRANSPORTATION	
	PROJECT NAME: BENNINGTON
	PROJECT NUMBER: AC NH 019-(153)
	FILE NAME: ...\\zd307c3xs_ramp.dwg
	PLOT DATE: 5/16/2011
DESIGN SUPERVISOR: GREG EDWARDS	DRAWN BY: STANTEC
DESIGNED BY: MARC FOISY	CHECKED BY: GARY SANTY
RAMP A CROSS SECTIONS	SHEET 404 OF 577