


A 1+440

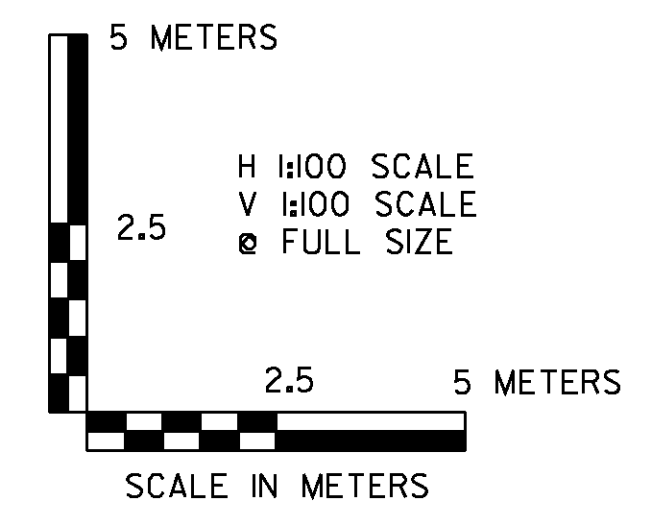

VERMONT AGENCY OF TRANSPORTATION	
	PROJECT NAME: BENNINGTON
	PROJECT NUMBER: AC NH 019-(153)
	FILE NAME: ...\\zd307c3xs_ramp_a.ptf
	PLOT DATE: 5/16/2011
DESIGN SUPERVISOR: GREG EDWARDS	DRAWN BY: STANTEC
DESIGNED BY: MARC FOISY	CHECKED BY: GARY SANTY
RAMP A CROSS SECTIONS	
	SHEET 411 OF 577

v:\953\active\9530002\transportation\drawing\contract_3\plot_files\zd307c3xs_ramp_a.ptf