


A 1+480

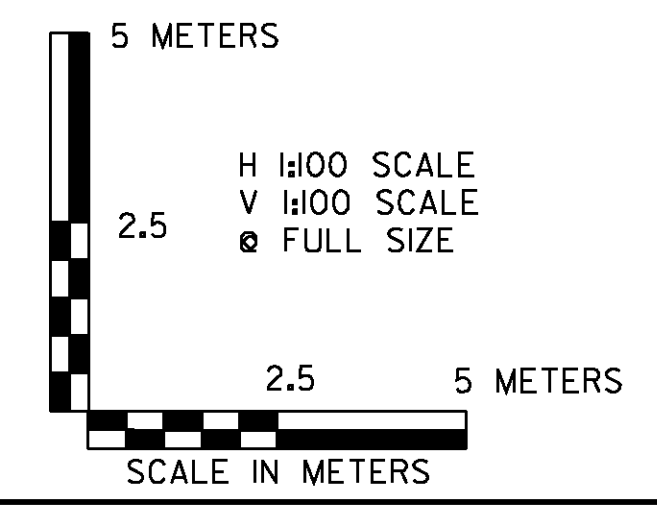

<b>VERMONT AGENCY OF TRANSPORTATION</b>	
	PROJECT NAME: BENNINGTON
	PROJECT NUMBER: AC NH 019-(153)
	FILE NAME: ...\\zd307c3xs_ramp_a.ptf
	PLOT DATE: 5/16/2011
DESIGN SUPERVISOR: GREG EDWARDS	DRAWN BY: STANTEC
DESIGNED BY: MARC FOISY	CHECKED BY: GARY SANTY
<b>RAMP A CROSS SECTIONS</b>	
	SHEET 413 OF 577

v:\953\active\9530002\transportation\drawing\contract\_3\plot\_files\zd307c3xs\_ramp\_a.ptf