


A 1+520

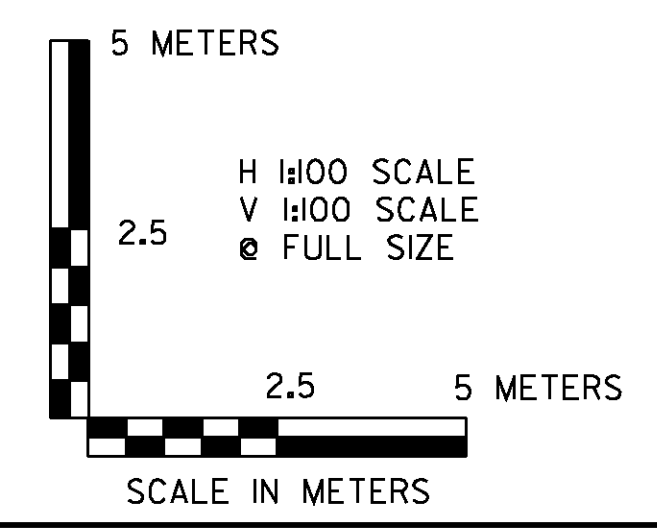

VERMONT AGENCY OF TRANSPORTATION	
	PROJECT NAME: BENNINGTON
	PROJECT NUMBER: AC NH 019-(153)
	FILE NAME: ...\\zd307c3xs_ramp_a.ptf
DESIGN SUPERVISOR: GREG EDWARDS	PLOT DATE: 5/16/2011
DESIGNED BY: MARC FOISY	DRAWN BY: STANTEC
RAMP A CROSS SECTIONS	CHECKED BY: GARY SANTY
	SHEET 415 OF 577

V:\953\active\9530002\transportation\drawing\contract_3\plot_files\zd307c3xs_ramp_a.ptf