


A 1+560



VERMONT AGENCY OF TRANSPORTATION

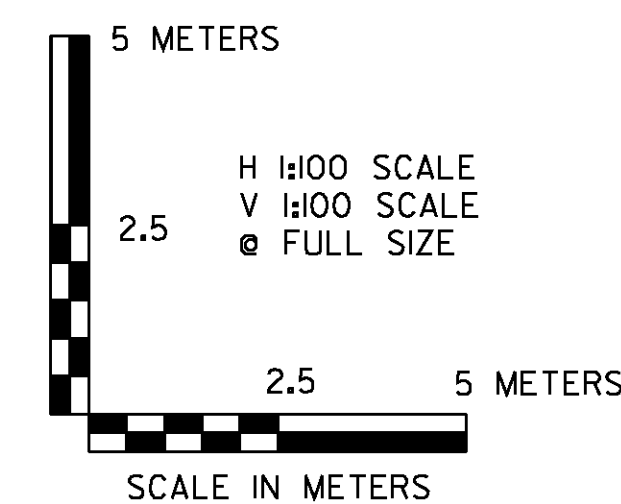

PROJECT NAME: BENNINGTON
 PROJECT NUMBER: AC NH 019-(153)

FILE NAME: ...\\zd307c3xs_ramp_a.pptf
 DESIGN SUPERVISOR: GREG EDWARDS
 DESIGNED BY: MARC FOISY

PLOT DATE: 5/16/2011
 DRAWN BY: STANTEC
 CHECKED BY: GARY SANTY
 SHEET 417 OF 577

RAMP A CROSS SECTIONS