


A 1+580



VERMONT AGENCY OF TRANSPORTATION

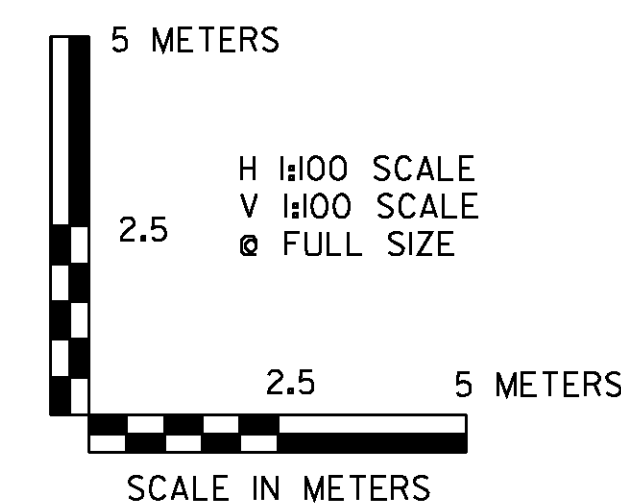

PROJECT NAME: BENNINGTON  
PROJECT NUMBER: AC NH 019-(153)

FILE NAME: ...\\zd307c3xs\_ramp\_a.pptf  
DESIGN SUPERVISOR: GREG EDWARDS  
DESIGNED BY: MARC FOISY

PLOT DATE: 5/16/2011  
DRAWN BY: STANTEC  
CHECKED BY: GARY SANTY  
SHEET 418 OF 577

RAMP A CROSS SECTIONS

V:\953\active\9530002\transportation\drawing\contract\_3\plot\_files\zd307c3xs\_ramp\_a.pptf