


A 1+620

V:\953\active\9530002\transportation\drawing\contract\_3\plot\_files\zd307c3xs\_ramp.dwg

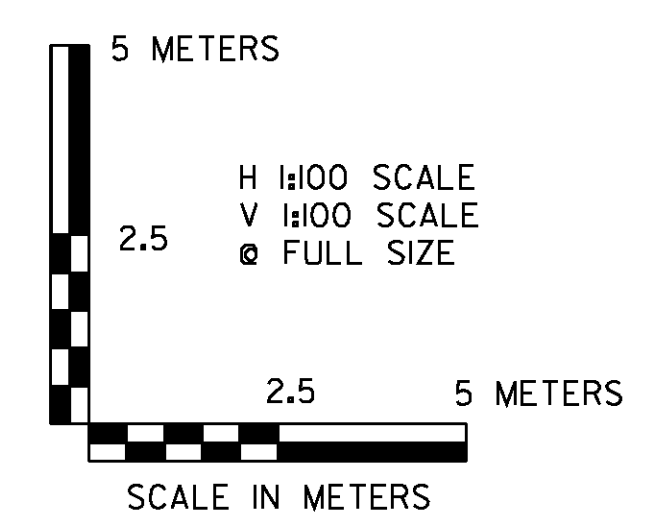

<b>VERMONT AGENCY OF TRANSPORTATION</b>	
	PROJECT NAME: BENNINGTON PROJECT NUMBER: AC NH 019-(153)
	FILE NAME: ...\\zd307c3xs_ramp.dwg DESIGN SUPERVISOR: GREG EDWARDS DESIGNED BY: MARC FOISY <b>RAMP A CROSS SECTIONS</b>