


A 1+640



VERMONT AGENCY OF TRANSPORTATION

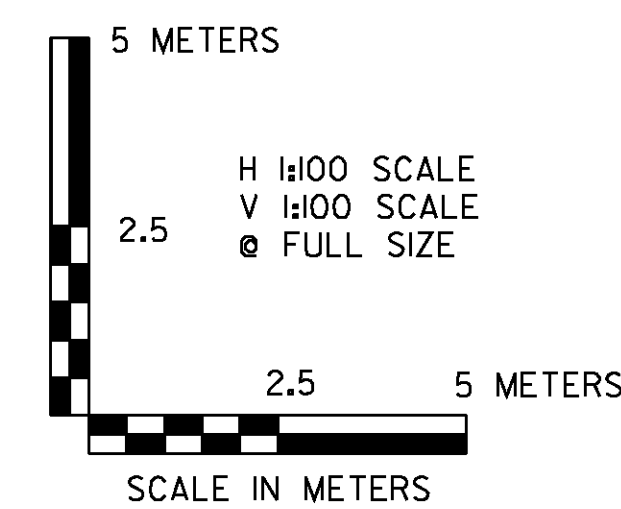

PROJECT NAME: BENNINGTON
PROJECT NUMBER: AC NH 019-(153)

FILE NAME: ...\\zd307c3xs_ramp_a.pptf
DESIGN SUPERVISOR: GREG EDWARDS
DESIGNED BY: MARC FOISY

PLOT DATE: 5/16/2011
DRAWN BY: STANTEC
CHECKED BY: GARY SANTY
SHEET 421 OF 577

RAMP A CROSS SECTIONS