
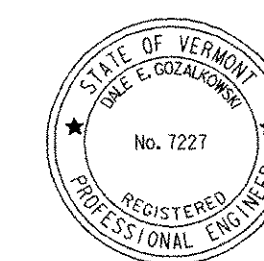


**STAGE ONE SITE LAYOUT PLAN**

FILE NAME = U:\9819\mstr\03\c\lough\Stage One Sites\zd048key01.dgn  
 DATE/TIME = 5/18/2007  
 USER = 3076

DATUM	
VERTICAL	NAVD 88
HORIZONTAL	NAD 83 (1992)

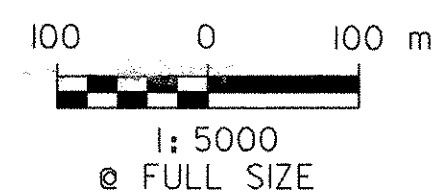

PLANS PREPARED BY  
*Dale E. Goyalkowski*

<b>VERMONT AGENCY OF TRANSPORTATION</b>	
<p><b>CHA</b>  <small>© 2007</small>                  CLOUGH HARBOUR &amp; ASSOCIATES LLP                  111 Winners Circle, PO Box 5266, Albany, NY 12205                  www.cloughharbour.com</p>	PROJECT NAME: BENNINGTON PROJECT NUMBER: AC NH 019-1(53)
	FILE NAME: ZD048KEY01.DGN PROJECT LEADER: D.E.G. DESIGNED BY: J.S.P. <b>SITE LAYOUT PLAN SLP-1</b>