





**CURVE A-1**  
 P.C. = STA. HRI+548.679  
 P.T. = STA. HRI+612.499  
 $\Delta = 18^\circ 16' 59.3''$  RT.  
 R=200.000 m  
 T=32.184 m  
 L=63.820 m  
 E=2.573 m  
 e<sub>max</sub>=N/A

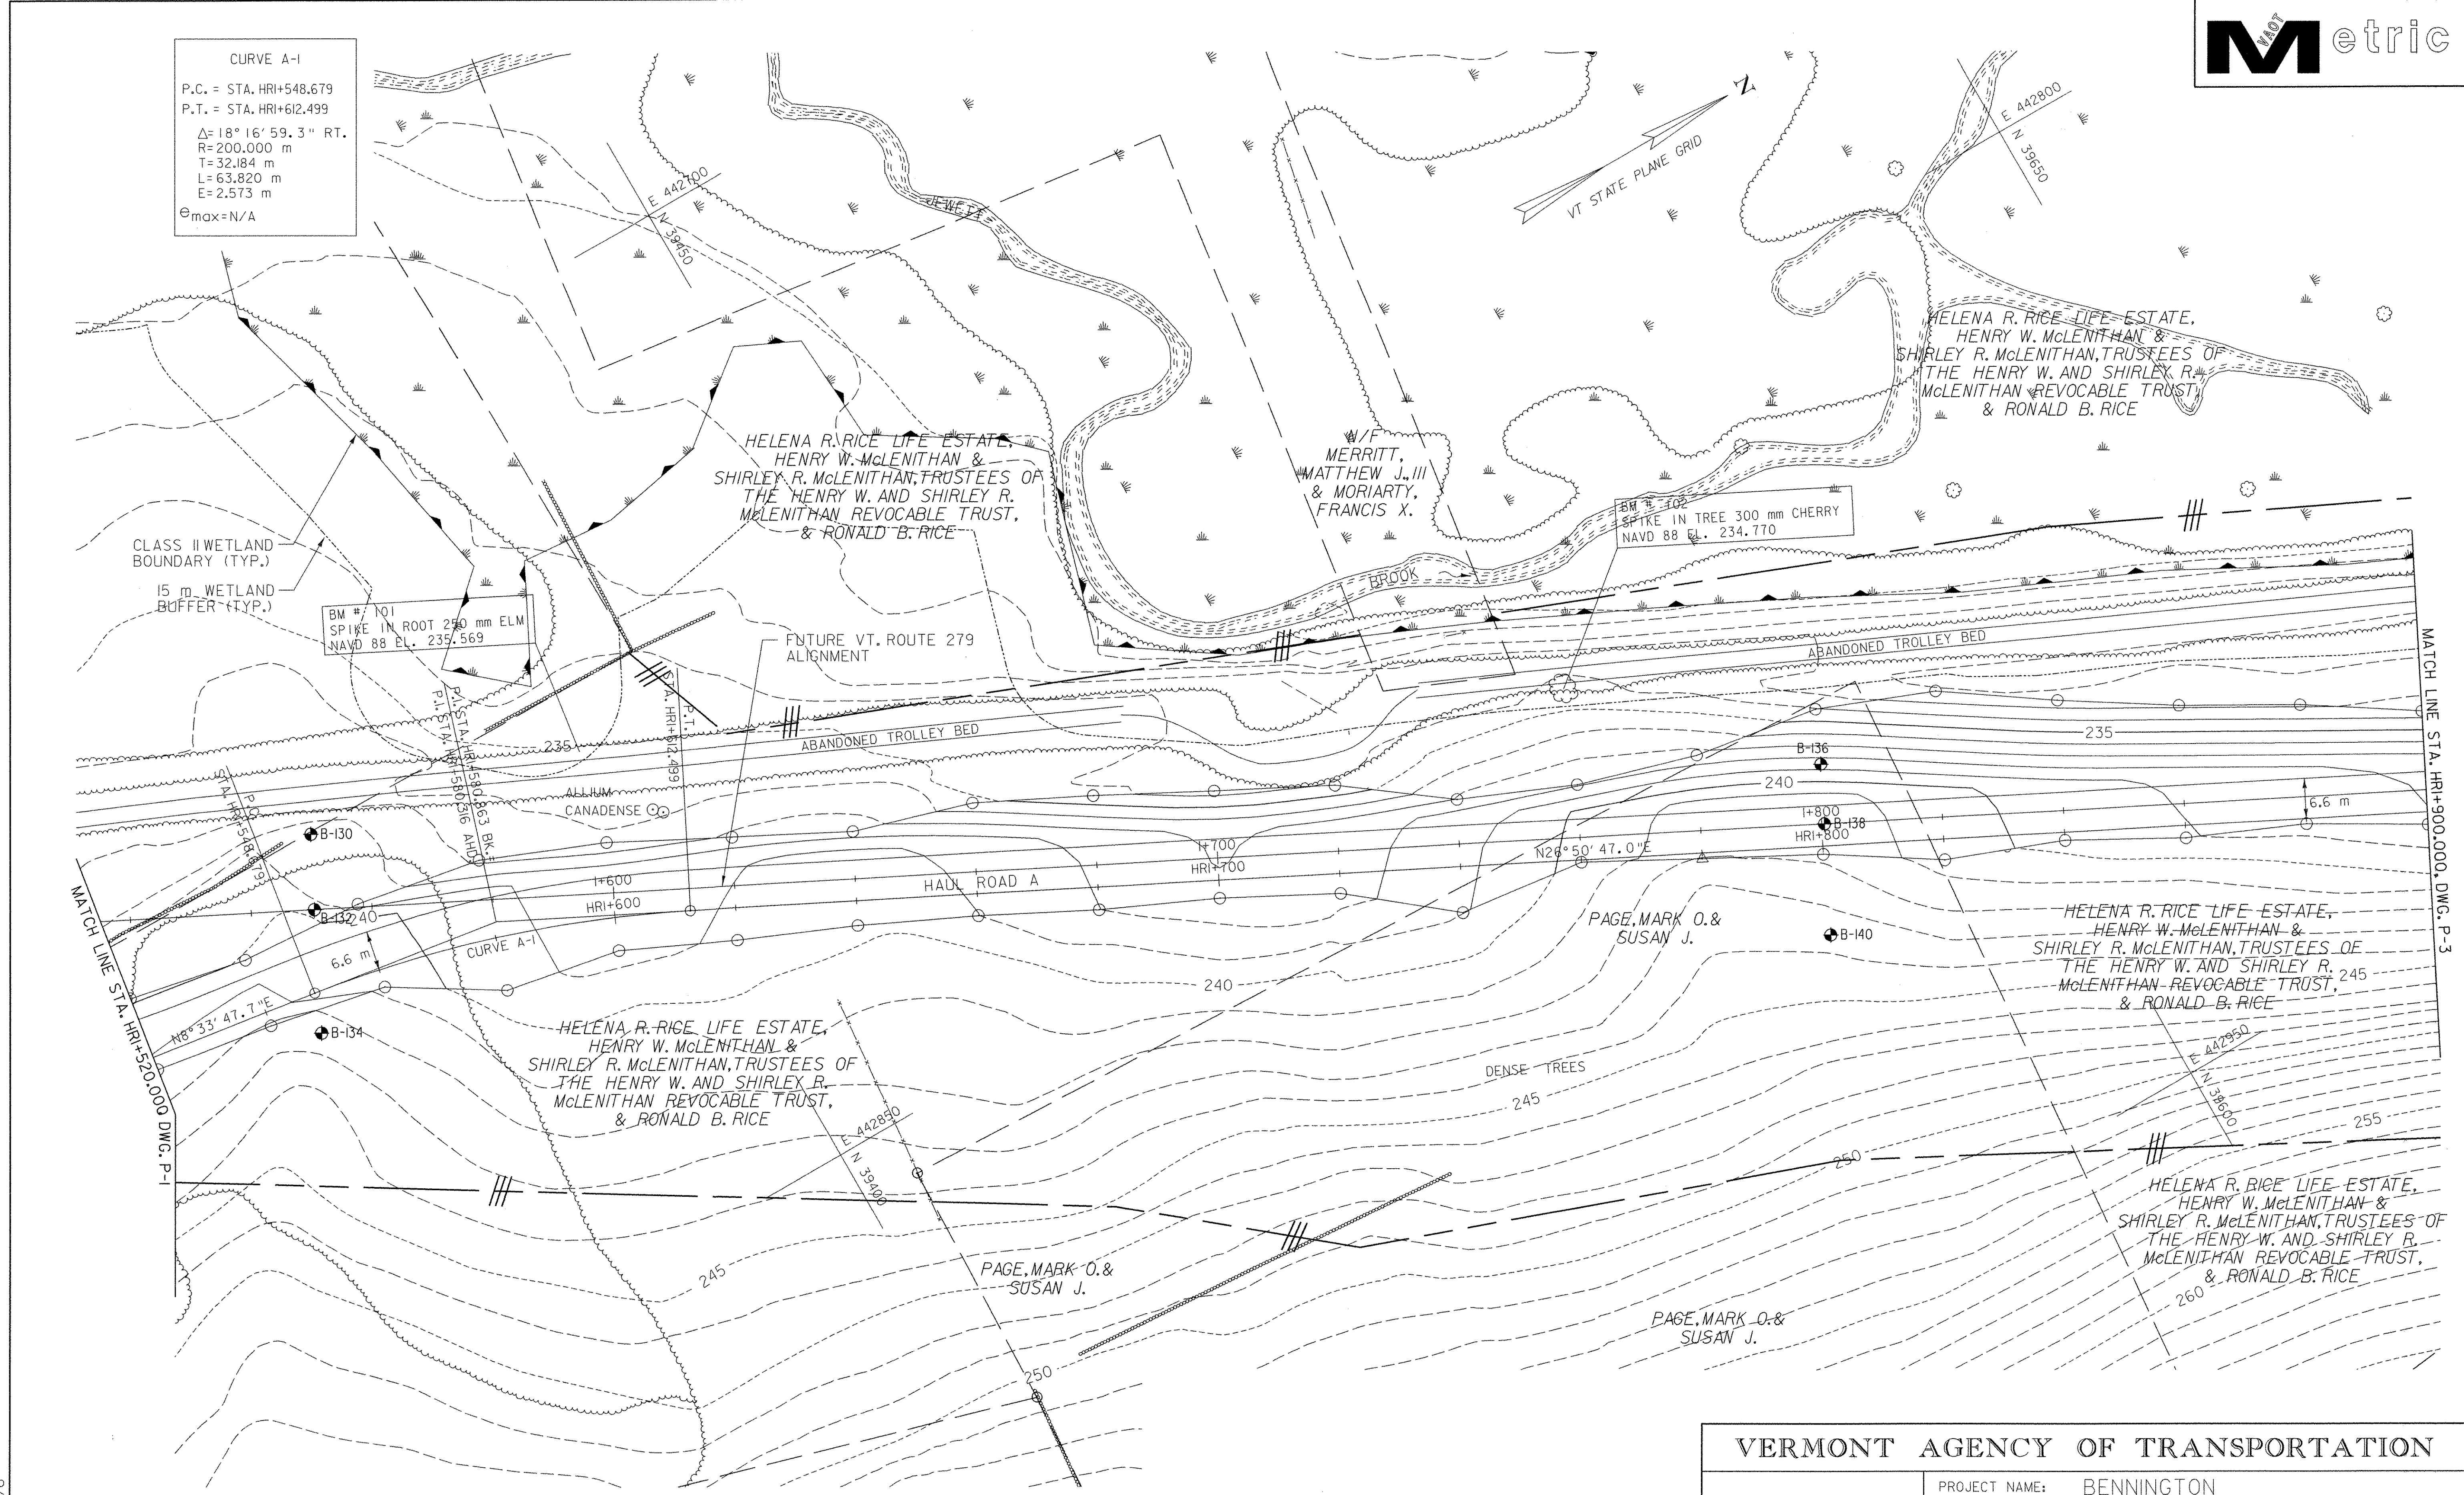

FILE NAME = U:\9919\mstrn\03\c\lough\Stage One Sites\z048p102.dgn  
 DATE / TIME = 5/18/2007  
 USER = 3076

DATUM	
VERTICAL	NAVD 88
HORIZONTAL	NAD 83 (1992)

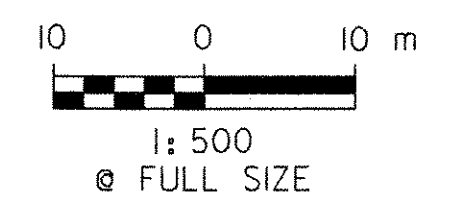

<b>VERMONT AGENCY OF TRANSPORTATION</b>	
 <b>CHA</b> <small>CLOUGH HARBOUR &amp; ASSOCIATES LLP</small> <small>111 Winners Circle, PO Box 5269, Albany, NY 12205</small> <small>www.cloughharbour.com</small>	PROJECT NAME: BENNINGTON PROJECT NUMBER: AC NH 019-1(53)
	FILE NAME: ZD048PL02.DGN PROJECT LEADER: D.E.G. DESIGNED BY: J.S.P. <b>PLAN P-2</b>