



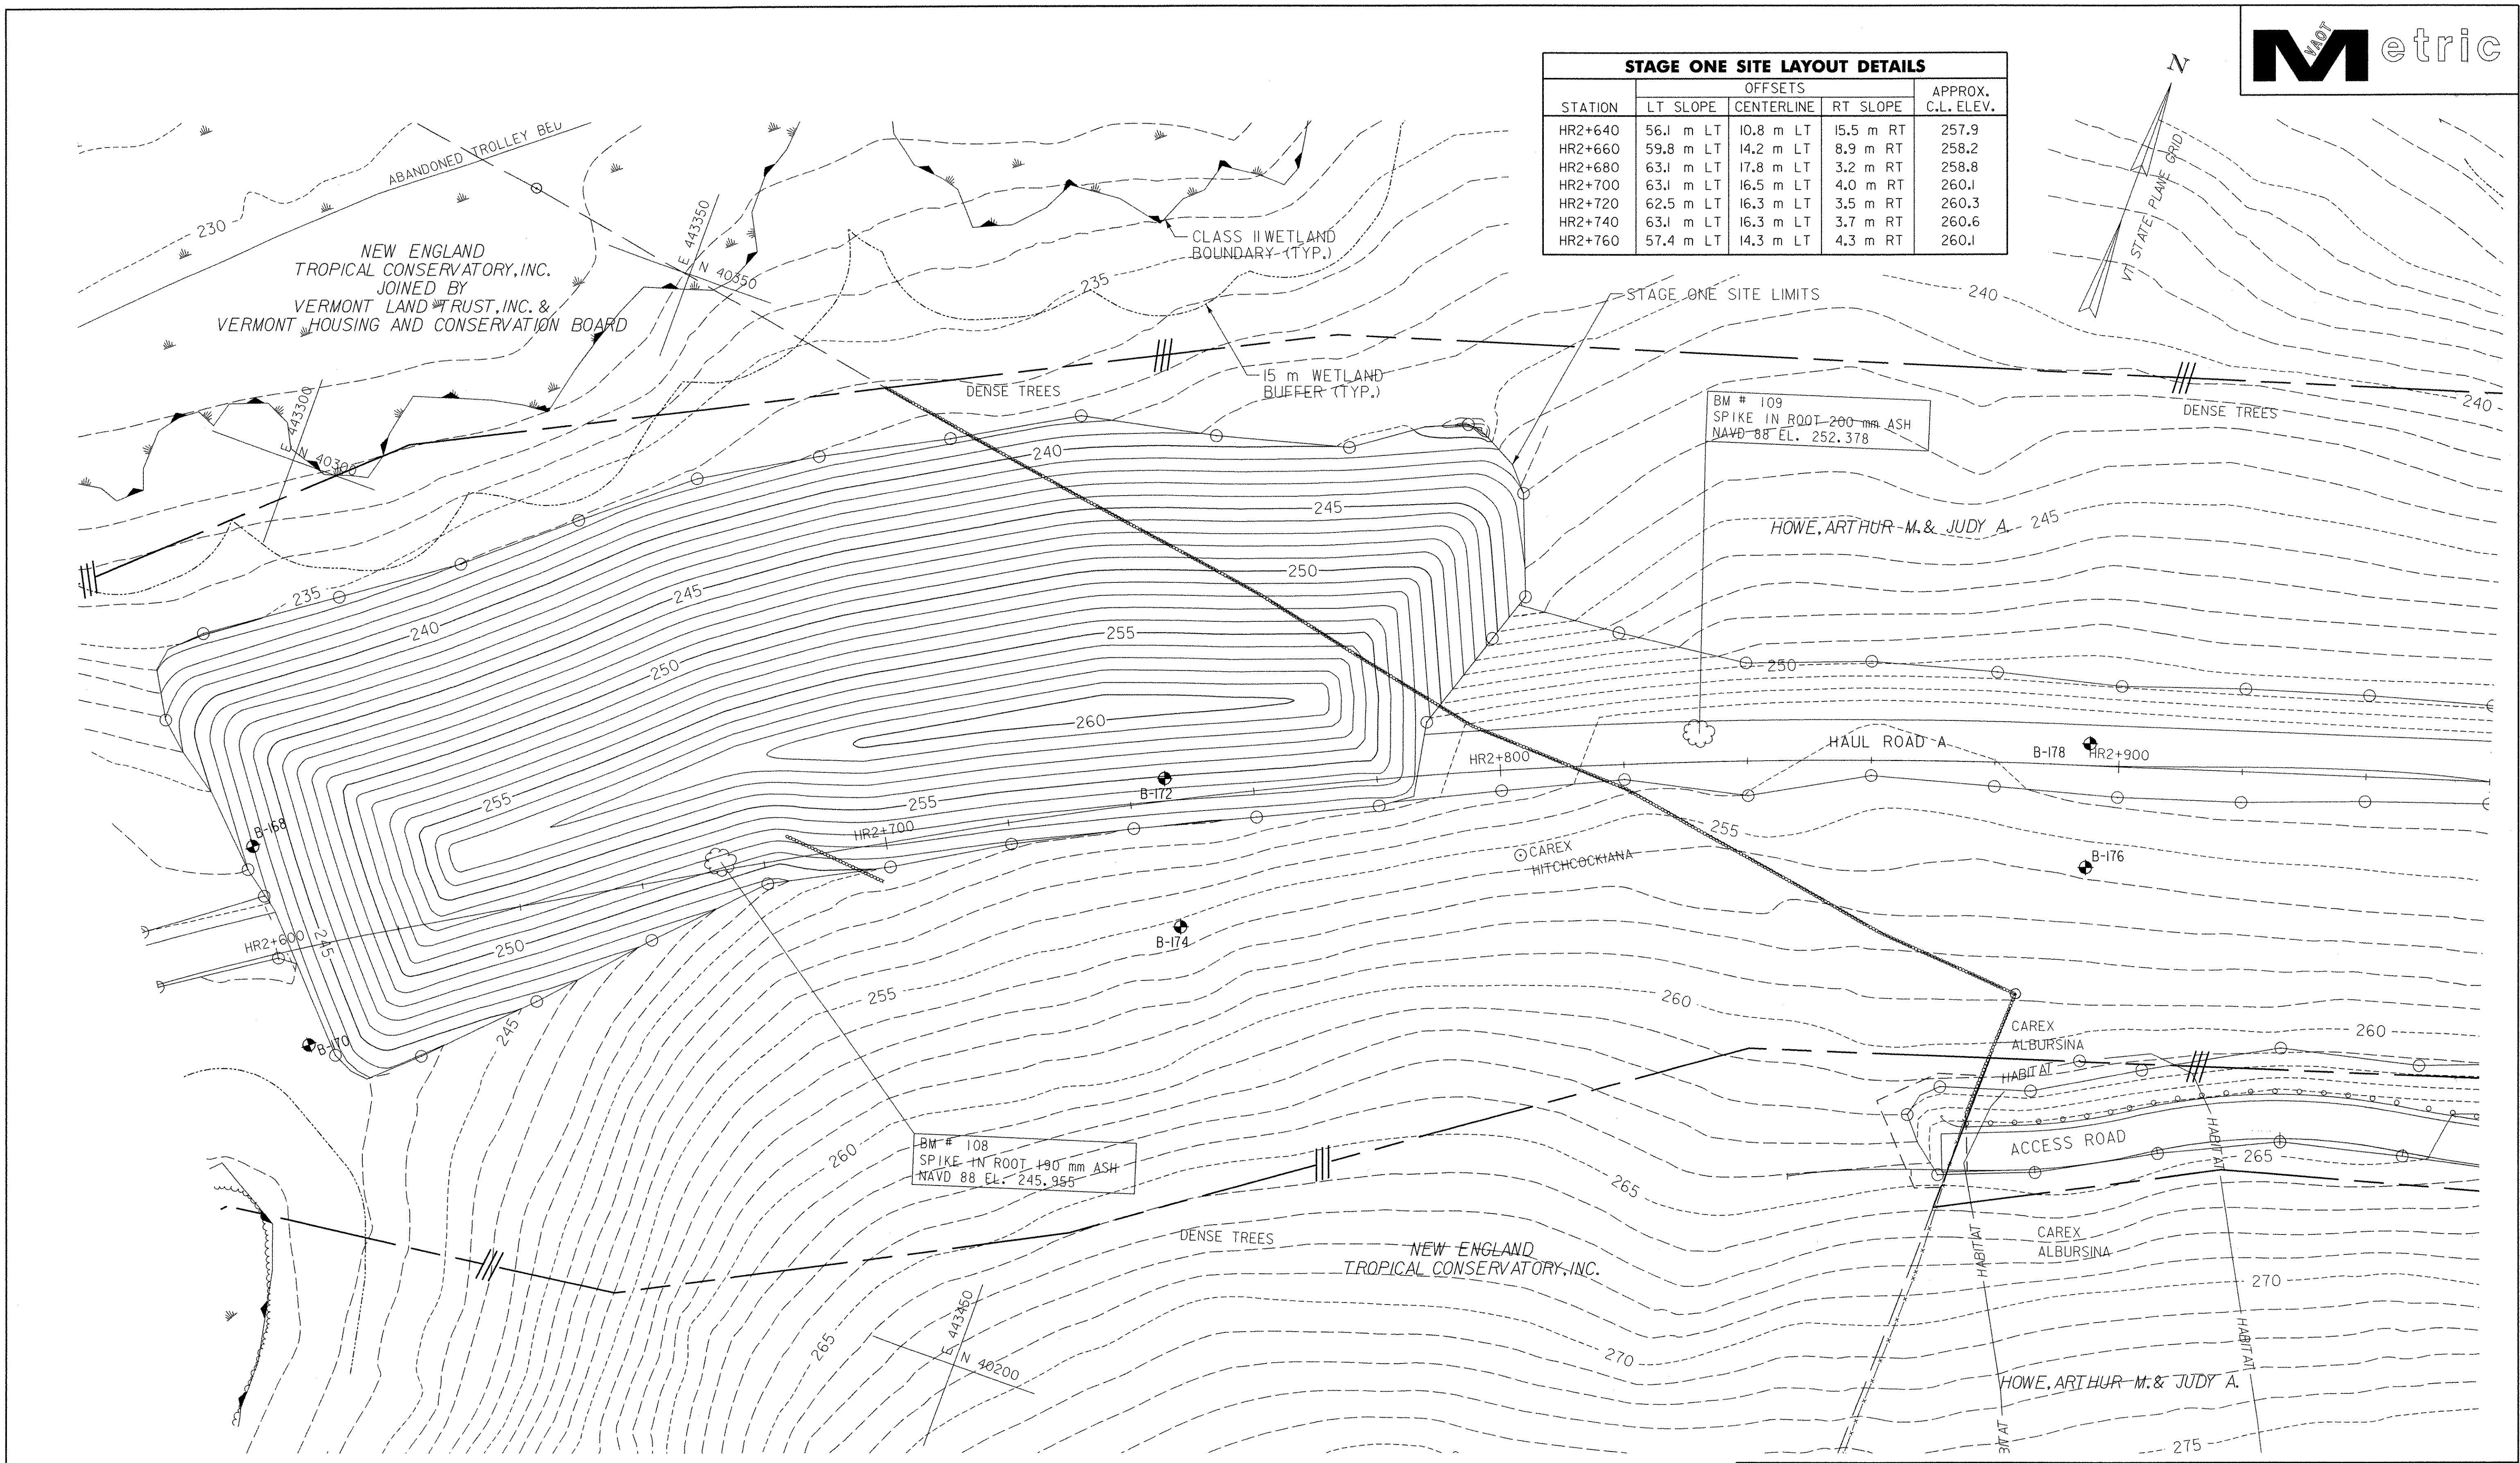


STATION	OFFSETS			APPROX. C.L. ELEV.
	LT SLOPE	CENTERLINE	RT SLOPE	
HR2+640	56.1 m LT	10.8 m LT	15.5 m RT	257.9
HR2+660	59.8 m LT	14.2 m LT	8.9 m RT	258.2
HR2+680	63.1 m LT	17.8 m LT	3.2 m RT	258.8
HR2+700	63.1 m LT	16.5 m LT	4.0 m RT	260.1
HR2+720	62.5 m LT	16.3 m LT	3.5 m RT	260.3
HR2+740	63.1 m LT	16.3 m LT	3.7 m RT	260.6
HR2+760	57.4 m LT	14.3 m LT	4.3 m RT	260.1

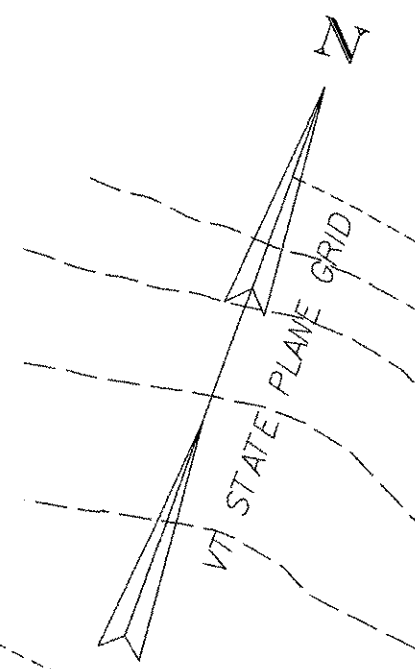

FILE NAME = I:\9819\mstr\03\c\lough\Stage One Sites\z048s02.dgn
 DATE/TIME = 5/18/2007
 USER = 3076

DATUM	
VERTICAL	NAVD 88
HORIZONTAL	NAD 83 (1992)

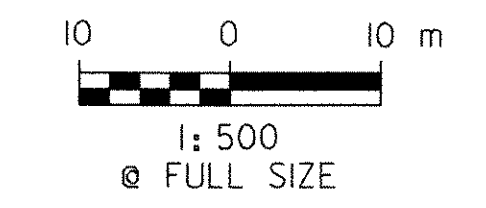

VERMONT AGENCY OF TRANSPORTATION	
CHA CLOUGH HARBOUR & ASSOCIATES LLP 11 Winslow Circle, PO Box 5269, Albany, NY 12205 www.cloughharbour.com	PROJECT NAME: BENNINGTON
	PROJECT NUMBER: AC NH 019-1(53)
FILE NAME: ZD048S0S02.DGN	PLOT DATE: 5/18/2007
PROJECT LEADER: D.E.G.	DRAWN BY: J.S.P.
DESIGNED BY: J.S.P.	CHECKED BY: D.E.G.
STAGE ONE SITE DETAILS S0S-2	SHEET 440 OF 577