


NOTES:

1. SEE VAOT STD. E-100 FOR ADDITIONAL SIGN PLACEMENT.
2. CONSTRUCTION ZONE SIGN LAYOUT SHALL BE IN ACCORDANCE WITH SECTION 6 OF THE LATEST EDITION OF THE MANUAL ON UNIFORM TRAFFIC CONTROL DEVICES (MUTCD).
3. CONSTRUCTION SIGNS SHALL BE IN NEW OR LIKE NEW CONDITION PER VAOT STANDARDS.
4. DIAMOND SHAPED SIGNS SHALL BE 4' X 4' WITH BLACK LEGEND ON FLUORESCENT ORANGE BACKGROUND.
5. PORTABLE CHANGEABLE MESSAGE SIGNS SHALL BE LOCATED AS DIRECTED BY THE RESIDENT ENGINEER. PAYMENT FOR PORTABLE CHANGEABLE MESSAGE SIGNS SHALL BE MADE UNDER ITEM 641J5 PORTABLE CHANGEABLE MESSAGE SIGNS.

FILE NAME = I:\9819\mstr\03\clough\Stage One Sites\zd048cas01.dgn
 DATE/TIME = 5/18/2007
 USER = 3076

DATUM	
VERTICAL	NAVD 88
HORIZONTAL	NAD 83 (1992)

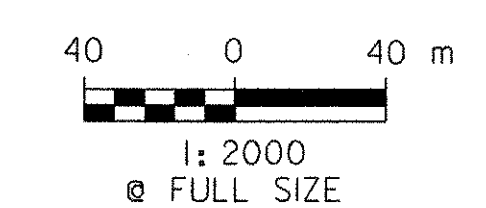

VERMONT AGENCY OF TRANSPORTATION	
 <small>CLOUGH HARBOUR & ASSOCIATES LLP</small> <small>11 Winners Circle, PO Box 5269, Albany, NY 12205</small> <small>www.cloughharbour.com</small>	PROJECT NAME: BENNINGTON PROJECT NUMBER: AC NH 019-1(53)
	FILE NAME: ZD048CAS01.DGN PROJECT LEADER: D.E.G. DESIGNED BY: J.S.P.
CONSTRUCTION APPROACH SIGNING CAS-1 SHEET 444 OF 577	