


FILE NAME = U:\9818\ms\tr\03\clough\EROSION\zd048gp1.dgn
 DATE / TIME = 5/21/2007
 USER = 1459

DATUM	
VERTICAL	NAVD 88
HORIZONTAL	NAD 83 (1992)

PROPOSED CONSTRUCTION THIS PHASE

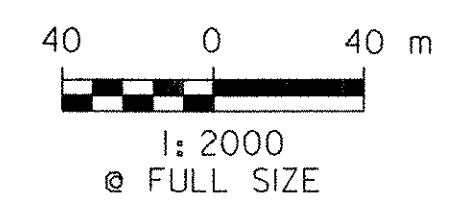

PHASE I PLAN LAYOUT	
VERMONT AGENCY OF TRANSPORTATION	
 <small>CLOUGH HARBOUR & ASSOCIATES LLP 11 Winners Circle, PO Box 5299, Albany, NY 12205 www.cloughharbour.com</small>	PROJECT NAME: BENNINGTON PROJECT NUMBER: AC NH 019-(K53)
	FILE NAME: ZD048gp1.DGN PROJECT LEADER: D.E.G. DESIGNED BY: D.W.E.
EROSION CONTROL PLAN ECP-1	
SHEET 462 OF 577	