


PHASE II PLAN LAYOUT

VERMONT AGENCY OF TRANSPORTATION



PROJECT NAME: BENNINGTON	PLOT DATE: 5/21/2007
PROJECT NUMBER: AC NH 019-1(53)	DRAWN BY: C.A.K.
FILE NAME: ZD048gp4.DGN	CHECKED BY: D.E.G.
PROJECT LEADER: D.E.G.	SHEET 472 OF 577
DESIGNED BY: D.W.E.	
EROSION CONTROL PLAN ECP-11	

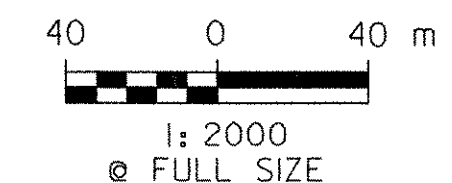

DATUM	
VERTICAL	NAVD 88
HORIZONTAL	NAD 83 (1992)

PROPOSED CONSTRUCTION THIS PHASE

FILE NAME = U:\9819\mstn\03\clough\EROSION\zd048gp4.dgn
 DATE/TIME = 5/21/2007
 USER = JLS