


LEGEND


- ⊗⊗⊗⊗⊗ **BARRIER FENCE**
- — — — — **GEOTEXTILE FOR SILT FENCE**
- PDF — **PROJECT DEMARCATION FENCE**
- ▨▨▨▨▨ **STUMP DISPOSAL AREA**
- ▩▩▩▩▩ **MAINTENANCE REFUELING AREAS**
- ▧▧▧▧▧ **TOPSOIL STOCKPILE AREA**
- ▩▩▩▩▩ **TRACKING PAD**
- ▨▨▨▨▨ **TEMPORARY EROSION MATTING**
- ▶▶▶▶▶ **TEMPORARY STONE CHECK DAM, TYPE I**
- ▶▶▶▶▶ **PREFABRICATED CHECK DAM**

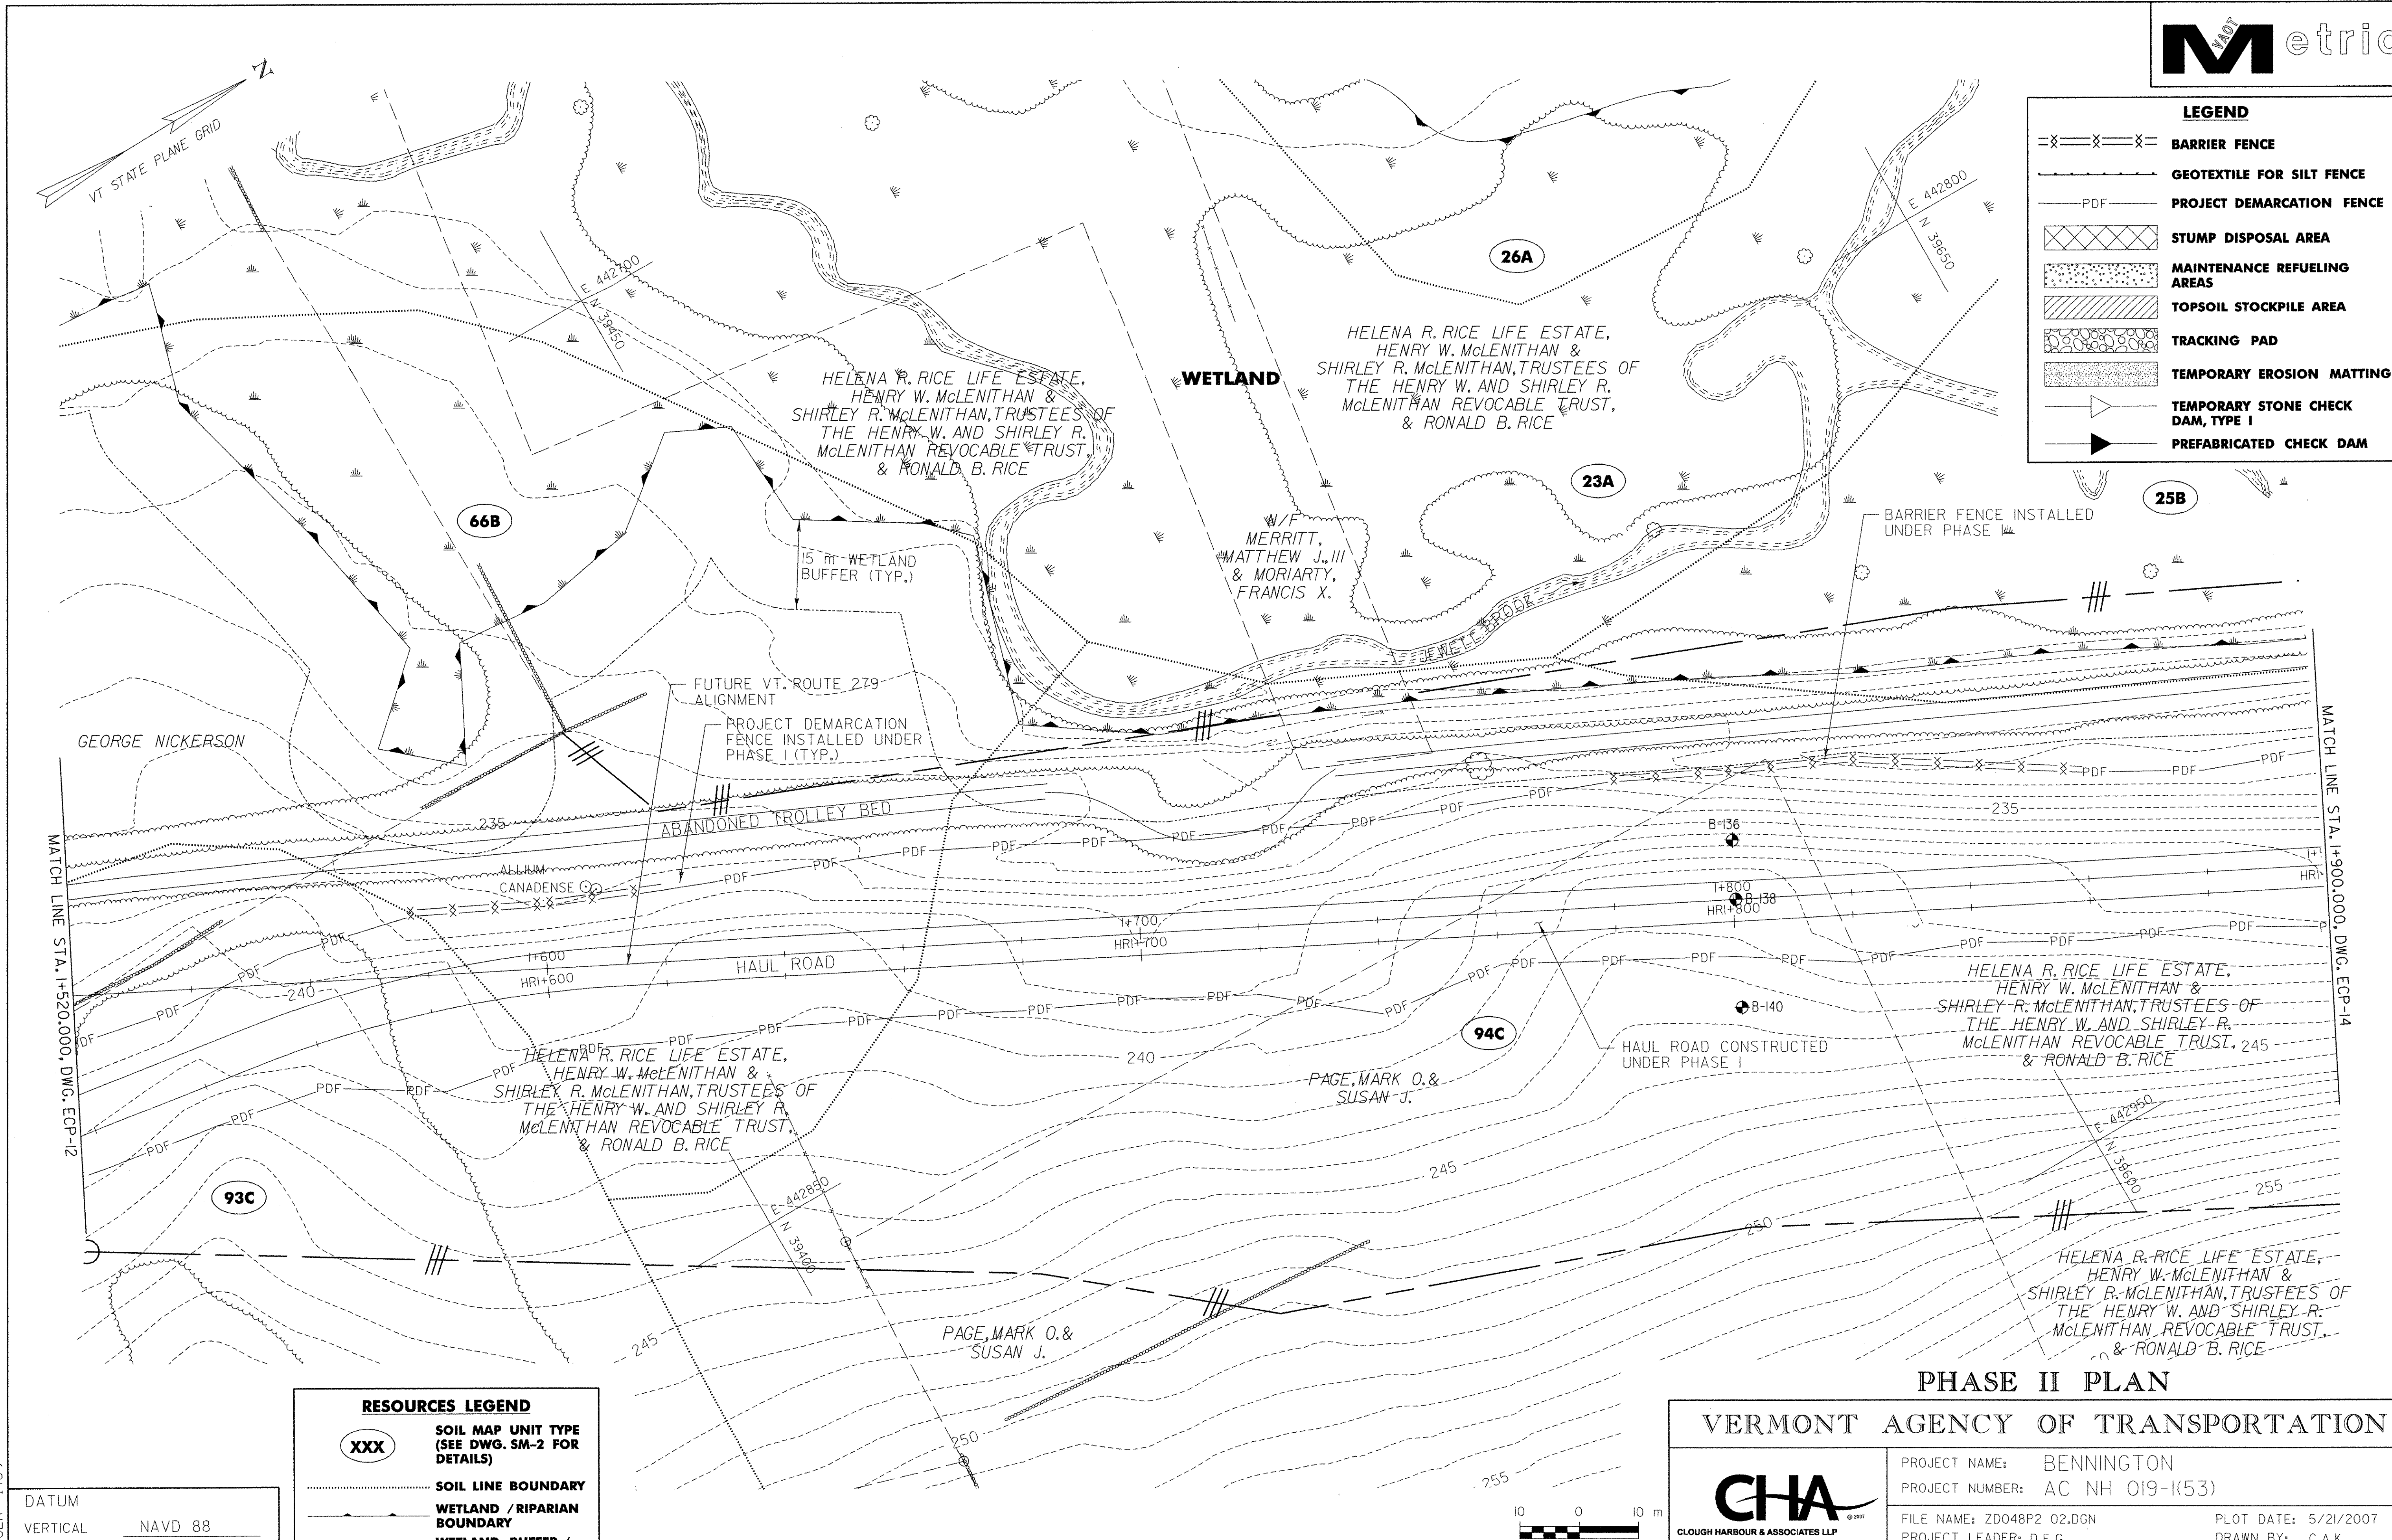

RESOURCES LEGEND

- XXX **SOIL MAP UNIT TYPE (SEE DWG. SM-2 FOR DETAILS)**
- — — — — **SOIL LINE BOUNDARY**
- — — — — **WETLAND / RIPARIAN BOUNDARY**
- — — — — **WETLAND BUFFER / RIPARIAN BUFFER**

DATUM	
VERTICAL	NAVD 88
HORIZONTAL	NAD 83 (1992)

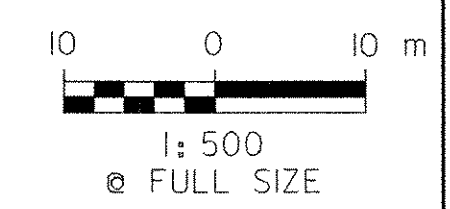

PHASE II PLAN

VERMONT AGENCY OF TRANSPORTATION

	PROJECT NAME: BENNINGTON	PLOT DATE: 5/21/2007
	PROJECT NUMBER: AC NH 019-1(53)	DRAWN BY: C.A.K.
	FILE NAME: ZD048P2 02.DGN	CHECKED BY: D.E.G.
	PROJECT LEADER: D.E.G.	SHEET 474 OF 577

EROSION CONTROL PLAN ECP-13

FILE NAME = I:\9819\mstn\03\clough\EROSION\zd048p2_02.dgn
 DATE/TIME = 5/21/2007
 USER = 1489