


LEGEND	
	BARRIER FENCE
	GEOTEXTILE FOR SILT FENCE
	PROJECT DEMARCATION FENCE
	STUMP DISPOSAL AREA
	MAINTENANCE REFUELING AREAS
	TOPSOIL STOCKPILE AREA
	TRACKING PAD
	TEMPORARY EROSION MATTING
	TEMPORARY STONE CHECK DAM, TYPE I
	PREFABRICATED CHECK DAM

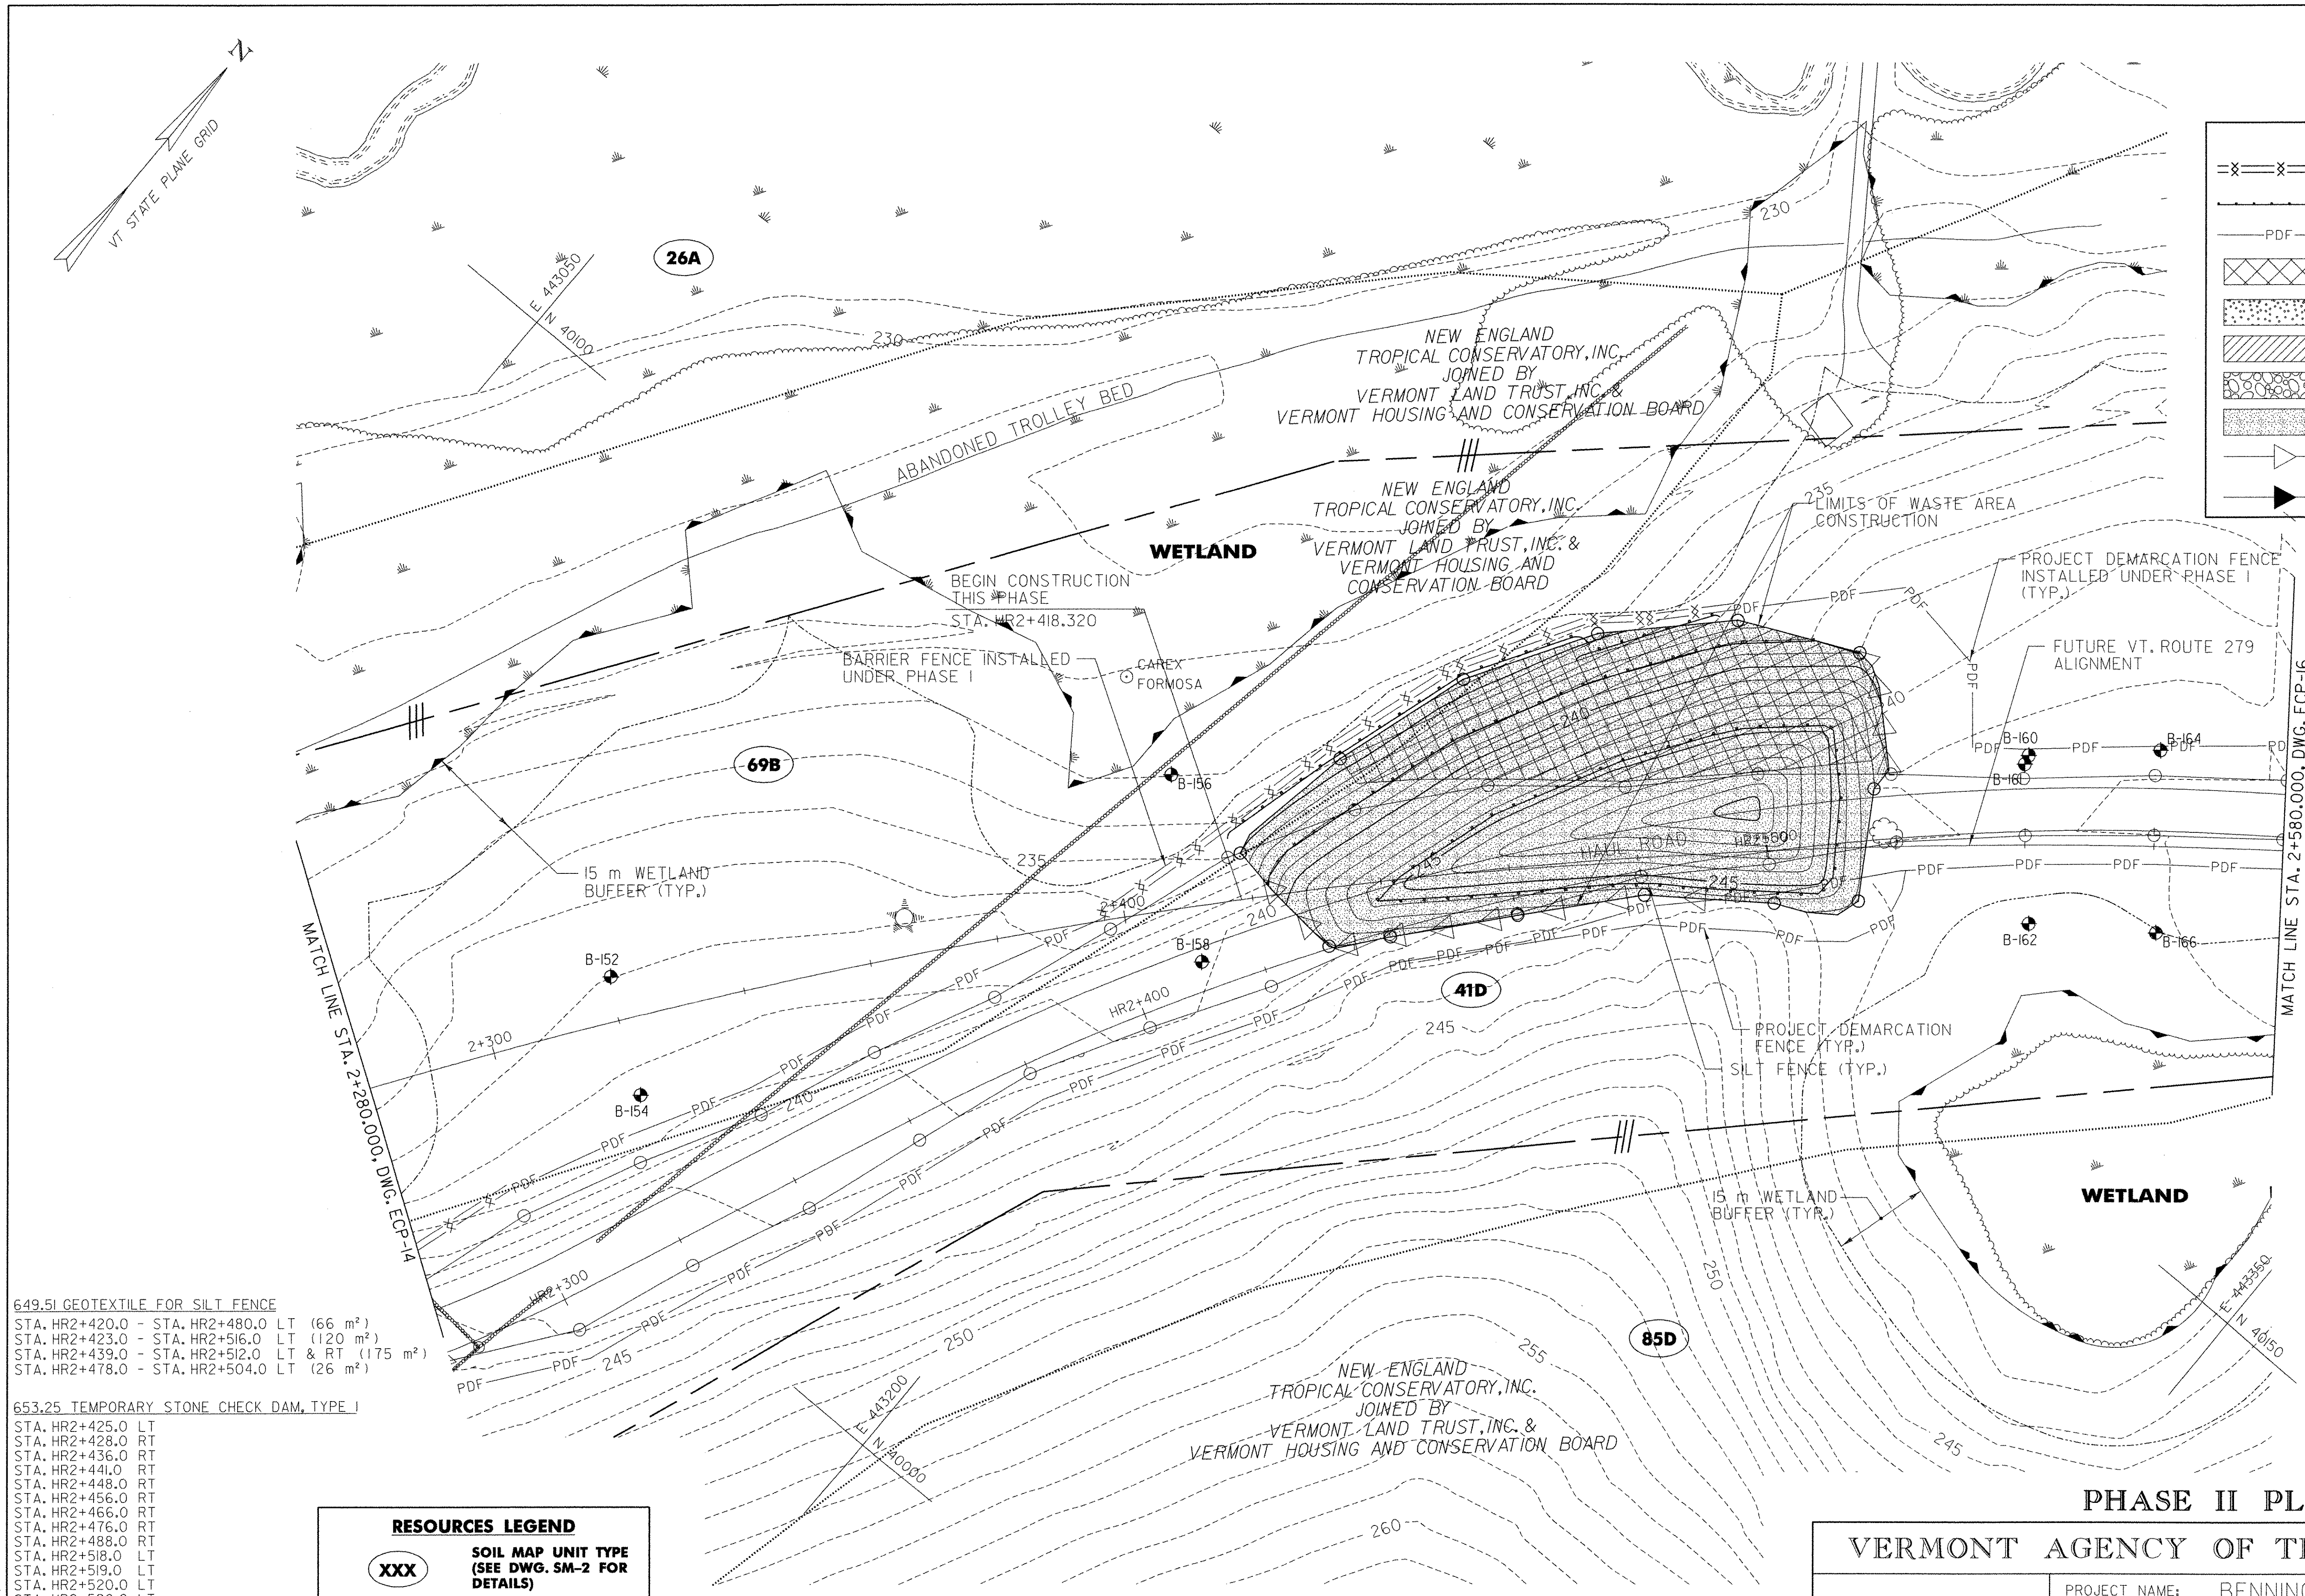

649.51 GEOTEXTILE FOR SILT FENCE

STA. HR2+420.0 - STA. HR2+480.0 LT	(66 m ²)
STA. HR2+423.0 - STA. HR2+516.0 LT	(120 m ²)
STA. HR2+439.0 - STA. HR2+512.0 LT & RT	(175 m ²)
STA. HR2+478.0 - STA. HR2+504.0 LT	(26 m ²)

653.25 TEMPORARY STONE CHECK DAM, TYPE I

STA. HR2+425.0 LT
STA. HR2+428.0 RT
STA. HR2+436.0 RT
STA. HR2+441.0 RT
STA. HR2+448.0 RT
STA. HR2+456.0 RT
STA. HR2+466.0 RT
STA. HR2+476.0 RT
STA. HR2+488.0 RT
STA. HR2+518.0 LT
STA. HR2+519.0 LT
STA. HR2+520.0 LT
STA. HR2+520.0 LT

RESOURCES LEGEND	
	SOIL MAP UNIT TYPE (SEE DWG. SM-2 FOR DETAILS)
	SOIL LINE BOUNDARY
	WETLAND / RIPARIAN BOUNDARY
	WETLAND BUFFER / RIPARIAN BUFFER


DATUM	
VERTICAL	NAVD 88
HORIZONTAL	NAD 83 (1992)

653.20 TEMPORARY EROSION MATTING

STA. HR2+420.0 - STA. HR2+518.0 LT & RT	(3583 m ²)
-----------------------------------------	------------------------

653.55 PROJECT DEMARCATION FENCE

STA. HR2+438.0 - STA. HR2+522.0 RT	(87 m)
------------------------------------	--------

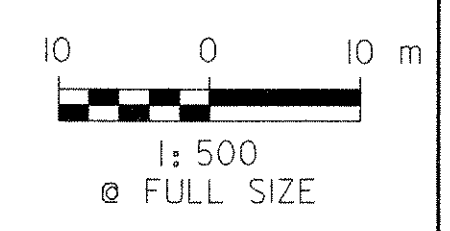

PHASE II PLAN
VERMONT AGENCY OF TRANSPORTATION



PROJECT NAME:	BENNINGTON	PLOT DATE:	5/21/2007
PROJECT NUMBER:	AC NH 019-I(53)	DRAWN BY:	C.A.K.
FILE NAME:	ZD048P2 04.DGN	CHECKED BY:	D.E.G.
PROJECT LEADER:	D.E.G.	SHEET	476 OF 577
DESIGNED BY:	D.W.E.	EROSION CONTROL PLAN ECP-15	

FILE NAME = U:\9819\ms\tr\03\c.lough\EROSION\zd048p2_04.dgn
DATE/TIME = 5/21/2007
USER = 1459