


EMBANKMENTS AT THE STAGE I SITES, AS INDICATED ON PLAN SHEETS 480 THROUGH 558, WERE NOT CONSTRUCTED AS INDICATED ON THESE SHEETS.

BY CHANGE OF DESIGN #20 AND WRITTEN ORDER #97, THE STATE AND THE CONTRACTOR AGREED ON THE FINAL DISPOSITION OF THE STAGE I SITES.

FINAL CROSS SECTIONS FOR ALL THE STAGE I SITES ARE CONTAINED IN A BINDER THAT IS LOCATED IN BOX 3 OF 15 OF THE CONTRACT RECORDS.

FILE NAME = us\9819\mstn\03\clough\stage One Sites\zd048xsc.f.dgn
DATE/TIME = 5/18/2007
USER = 597

DATUM	
VERTICAL	NAVD 88
HORIZONTAL	NAD 83 (1992)

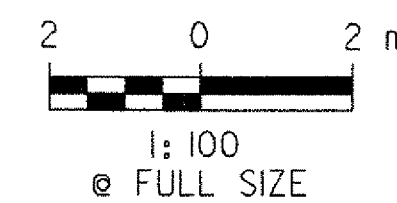

VERMONT AGENCY OF TRANSPORTATION



PROJECT NAME: BENNINGTON
PROJECT NUMBER: AC NH 019-(53)

FILE NAME: ZD048XSC.DGN
PROJECT LEADER: D.E.G.
DESIGNED BY: J.S.P.

PLOT DATE: 5/18/2007
DRAWN BY: J.S.P.
CHECKED BY: D.E.G.
SHEET 480 OF 577

CROSS SECTIONS XSC-1