




FILE NAME = u:\9819\mstrn\03\clough\stage One Sites\zd048xsc.f.dgn  
 DATE/TIME = 5/18/2007  
 USER = 597

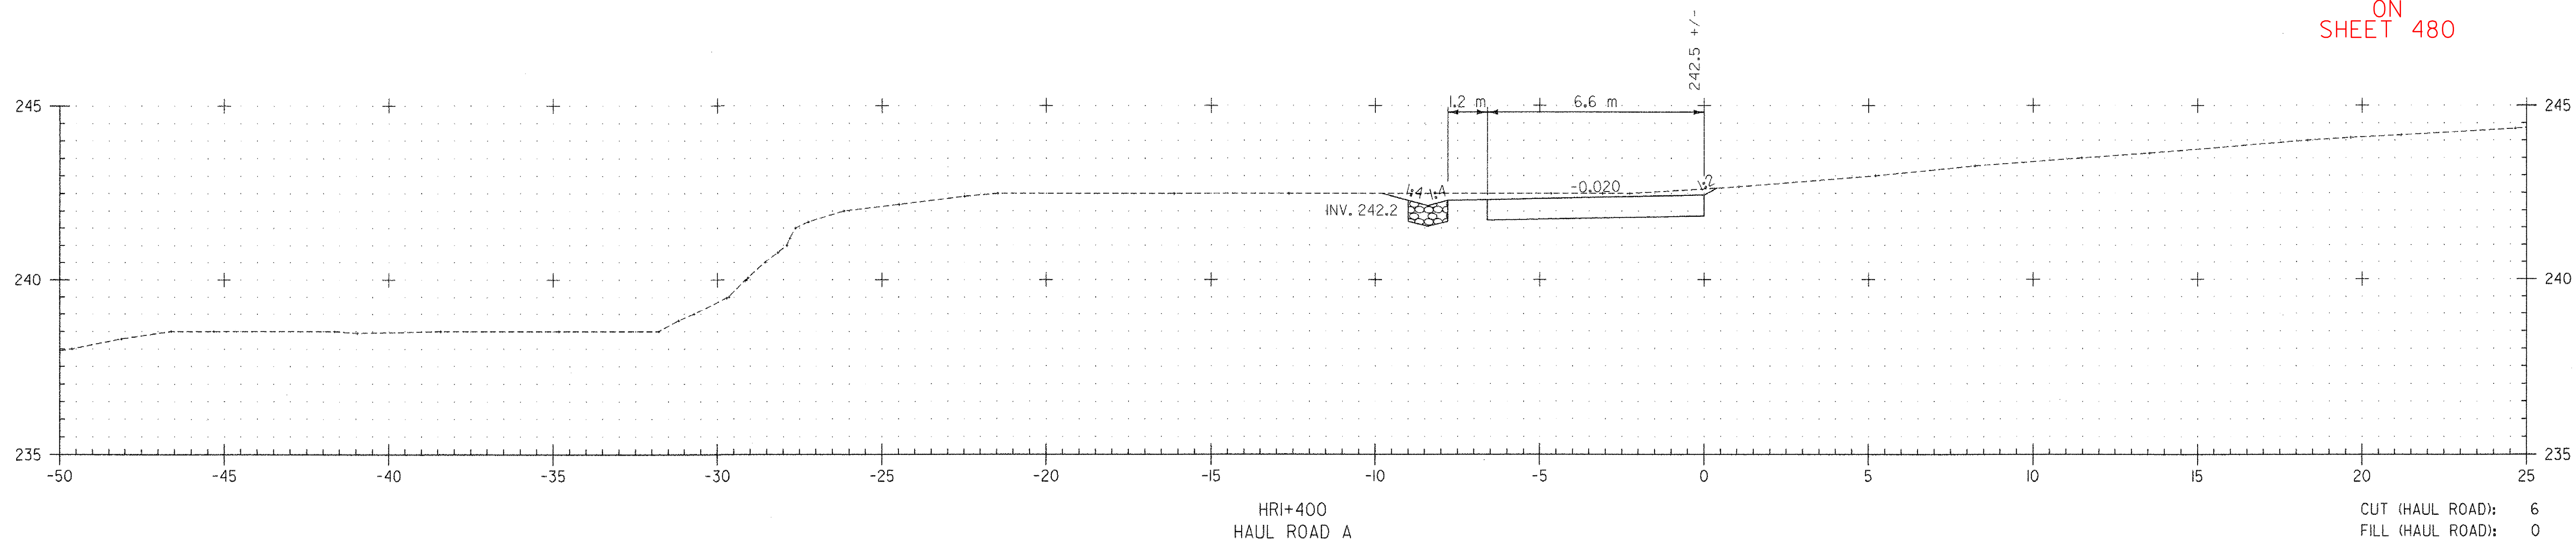

DATUM	
VERTICAL	NAVD 88
HORIZONTAL	NAD 83 (1992)

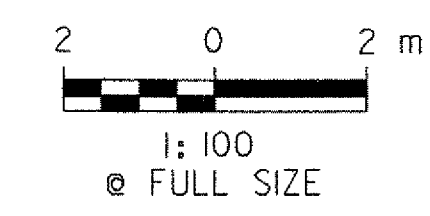

<b>VERMONT AGENCY OF TRANSPORTATION</b>	
 <b>CHA</b> CLOUGH HARBOUR & ASSOCIATES LLP <small>11 Winners Circle, PO Box 5286, Albany, NY 12205                  www.cloughharbour.com</small>	PROJECT NAME: BENNINGTON
	PROJECT NUMBER: AC NH 019-1(53)
FILE NAME: ZD048XSC.DGN	PLOT DATE: 5/18/2007
PROJECT LEADER: D.E.G.	DRAWN BY: J.S.P.
DESIGNED BY: J.S.P.	CHECKED BY: D.E.G.
<b>CROSS SECTIONS XSC-2</b>	SHEET 481 OF 577