


SEE NOTE  
ON  
SHEET 480

FILE NAME = F:\9819\mstn\03\clough\Stage One Sites\zd048xsc.f.dgn  
DATE/TIME = 5/18/2007  
USER = 597

DATUM	
VERTICAL	NAVD 88
HORIZONTAL	NAD 83 (1992)

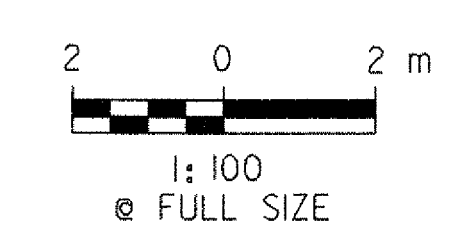

<b>VERMONT AGENCY OF TRANSPORTATION</b>	
<p><b>CHA</b> CLOUGH HARBOUR &amp; ASSOCIATES LLP 111 Winners Circle, PO Box 9286, Albany, NY 12205 www.cloughharbour.com</p>	PROJECT NAME: BENNINGTON PROJECT NUMBER: AC NH 019-1(53)
	FILE NAME: ZD048XSC.DGN PROJECT LEADER: D.E.G. DESIGNED BY: J.S.P. <b>CROSS SECTIONS XSC-3</b>