


SEE NOTE
ON
SHEET 480

FILE NAME = \$FILE\$
DATE/TIME = \$DATE\$
USER = \$USER\$

DATUM	
VERTICAL	NAVD 88
HORIZONTAL	NAD 83 (1992)

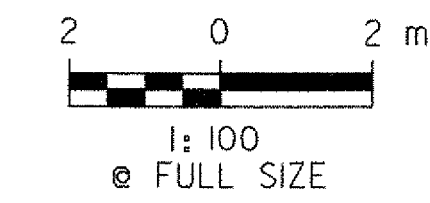

VERMONT AGENCY OF TRANSPORTATION	
<p>CHA CLOUGH HARBOUR & ASSOCIATES LLP 11 Winnet Circle, PO Box 6265, Albany, NY 12205 www.cloughharbour.com</p>	PROJECT NAME: BENNINGTON PROJECT NUMBER: AC NH 019-1(53)
	FILE NAME: ZD048XSC.DGN PROJECT LEADER: D.E.G. DESIGNED BY: J.S.P. CROSS SECTIONS XSC-4