


FILE NAME = \$FILE\$
DATE/TIME = \$DATE\$
USER = \$USER\$

DATUM
VERTICAL NAVD 88
HORIZONTAL NAD 83 (1992)

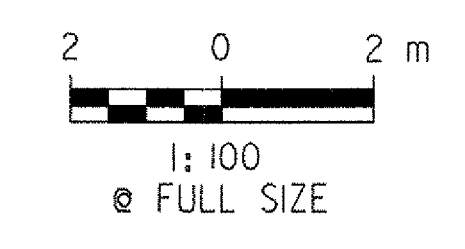

VERMONT AGENCY OF TRANSPORTATION	
 <small>CLOUGH HARBOUR & ASSOCIATES LLP</small> <small>11 Winnes Circle, PO Box 5266, Albany, NY 12205</small> <small>www.cloughharbour.com</small>	PROJECT NAME: BENNINGTON
	PROJECT NUMBER: AC NH 019-1(53)
	FILE NAME: ZD048XSC.DGN
	PLOT DATE: \$DATE\$
PROJECT LEADER: D.E.G.	DRAWN BY: J.S.P.
DESIGNED BY: J.S.P.	CHECKED BY: D.E.G.
CROSS SECTIONS XSC-5	SHEET 484 OF 577