


SEE NOTE
ON
SHEET 480

FILE NAME = \$FILE\$
DATE/TIME = \$DATE\$
USER = \$NTUSER\$

DATUM
VERTICAL NAVD 88
HORIZONTAL NAD 83 (1992)

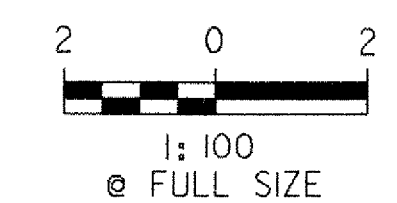

VERMONT AGENCY OF TRANSPORTATION



PROJECT NAME: BENNINGTON
PROJECT NUMBER: AC NH 019-(153)

FILE NAME: ZD048XSC.DGN
PROJECT LEADER: D.E.G.
DESIGNED BY: J.S.P.

CROSS SECTIONS XSC-7

PLOT DATE: \$DATE\$
DRAWN BY: J.S.P.
CHECKED BY: D.E.G.
SHEET 486 OF 577