


SEE NOTE
ON
SHEET 480

FILE NAME = \$FILE\$
DATE/TIME = \$DATE\$
USER = \$NTUSER\$

| | |
|------------|---------------|
| DATUM | |
| VERTICAL | NAVD 88 |
| HORIZONTAL | NAD 83 (1992) |

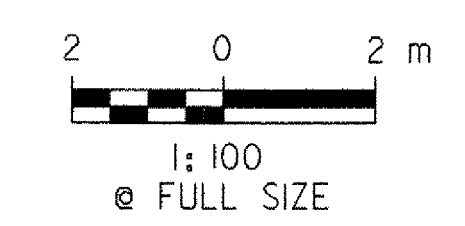

| | |
|---|--|
| VERMONT AGENCY OF TRANSPORTATION | |
| <p>CHA CLOUGH HARBOUR & ASSOCIATES LLP 11 Winners Circle, PO Box 5285, Albany, NY 12205 www.coughharbour.com</p> | PROJECT NAME: BENNINGTON PROJECT NUMBER: AC NH 019-(153) |
| | FILE NAME: ZD048XSC.DGN PROJECT LEADER: D.E.G. DESIGNED BY: J.S.P. |
| CROSS SECTIONS XSC-8 | |
| SHEET 487 OF 577 | |