


FILE NAME = \$FILE\$  
 DATE/TIME = \$DATE\$  
 USER = \$TUSER\$

DATUM	
VERTICAL	NAVD 88
HORIZONTAL	NAD 83 (1992)

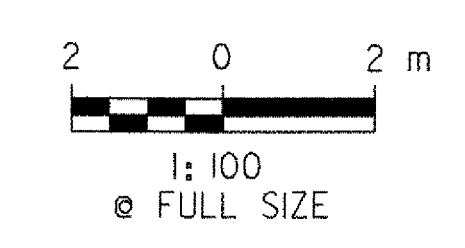

<b>VERMONT AGENCY OF TRANSPORTATION</b>	
 <small>CLOUGH HARBOUR &amp; ASSOCIATES LLP</small> <small>111 Winners Circle, PO Box 9266, Albany, NY 12205</small> <small>www.cloughharbour.com</small>	PROJECT NAME: BENNINGTON PROJECT NUMBER: AC NH 019-1(53)
	FILE NAME: ZD048XSC.DGN PROJECT LEADER: D.E.G. DESIGNED BY: J.S.P. <b>CROSS SECTIONS XSC-16</b>