


FILE NAME = \$FILE\$
DATE/TIME = \$DATE\$
USER = \$NTUSER\$

DATUM	
VERTICAL	NAVD 88
HORIZONTAL	NAD 83 (1992)



VERMONT AGENCY OF TRANSPORTATION

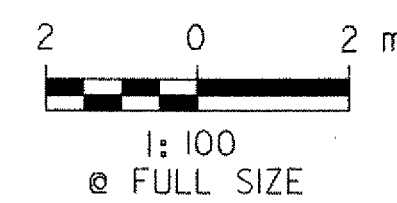

PROJECT NAME:	BENNINGTON	PLOT DATE:	\$DATE\$
PROJECT NUMBER:	AC NH 019-1(53)	DRAWN BY:	J.S.P.
FILE NAME:	ZD048XSC.DGN	CHECKED BY:	D.E.G.
PROJECT LEADER:	D.E.G.	SHEET	496 OF 577
DESIGNED BY:	J.S.P.	CROSS SECTIONS XSC-17	