


FILE NAME = \$FILE\$
 DATE/TIME = \$DATE\$
 USER = \$USER\$

| | |
|------------|---------------|
| DATUM | |
| VERTICAL | NAVD 88 |
| HORIZONTAL | NAD 83 (1992) |

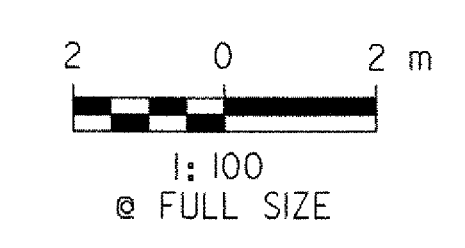

| | | | |
|--|-----------------|-----------------|------------|
| VERMONT AGENCY OF TRANSPORTATION | | | |
| CHA <small>CLOUGH HARBOUR & ASSOCIATES LLP</small> <small>111 Winners Circle, PO Box 5280, Albany, NY 12205</small> <small>www.cloughharbour.com</small> | PROJECT NAME: | BENNINGTON | |
| | PROJECT NUMBER: | AC NH 019-(153) | |
| | FILE NAME: | ZD048XSC.DGN | PLOT DATE: |
| PROJECT LEADER: | D.E.G. | DRAWN BY: | J.S.P. |
| DESIGNED BY: | J.S.P. | CHECKED BY: | D.E.G. |
| CROSS SECTIONS XSC-18 | | SHEET 497 | OF 577 |