



FILE NAME = \$FILE\$
DATE/TIME = \$DATE\$
USER = \$NTUSER\$

DATUM	
VERTICAL	NAVD 88
HORIZONTAL	NAD 83 (1992)

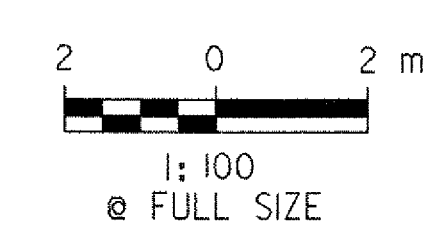

VERMONT AGENCY OF TRANSPORTATION	
 CHA <small>CLOUGH HARBOUR & ASSOCIATES LLP 111 Winners Circle, PO Box 5286, Albany, NY 12205 www.cloughharbour.com</small>	PROJECT NAME: BENNINGTON PROJECT NUMBER: AC NH 019-(153)
	FILE NAME: ZD048XSC.DGN PROJECT LEADER: D.E.G. DESIGNED BY: J.S.P. CROSS SECTIONS XSC-20