


HR2+180  
HAUL ROAD A

CUT (HAUL ROAD): 5  
FILL (HAUL ROAD): 6

FILE NAME = \$FILE\$  
DATE/TIME = \$DATE\$ \$  
USER = \$NTUSER\$

DATUM	
VERTICAL	NAVD 88
HORIZONTAL	NAD 83 (1992)

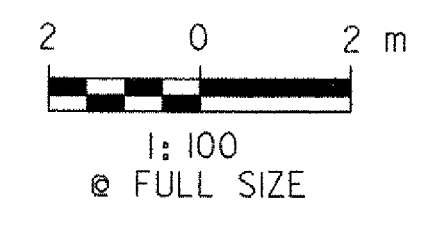

VERMONT AGENCY OF TRANSPORTATION



PROJECT NAME:	BENNINGTON	PLOT DATE:	\$DATE\$
PROJECT NUMBER:	AC NH 019-1(53)	DRAWN BY:	J.S.P.
FILE NAME:	ZD048XSC.DGN	DESIGNED BY:	J.S.P.
PROJECT LEADER:	D.E.G.	CHECKED BY:	D.E.G.
<b>CROSS SECTIONS XSC-28</b>		SHEET 507 OF 577	