



FILE NAME = \$FILE\$  
DATE/TIME = \$DATE\$  
USER = \$USER\$

DATUM	
VERTICAL	NAVD 88
HORIZONTAL	NAD 83 (1992)

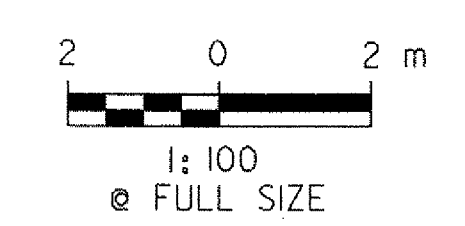

<b>VERMONT AGENCY OF TRANSPORTATION</b>	
 <b>CHA</b> <small>CLOUGH HARBOUR &amp; ASSOCIATES LLP</small> <small>11 Winners Circle, PO Box 5269, Albany, NY 12205</small> <small>www.cloughharbour.com</small>	PROJECT NAME: BENNINGTON
	PROJECT NUMBER: AC NH 019-(53)
FILE NAME: ZD048XSC.DGN	PLOT DATE: \$DATE\$
PROJECT LEADER: D.E.G.	DRAWN BY: J.S.P.
DESIGNED BY: J.S.P.	CHECKED BY: D.E.G.
<b>CROSS SECTIONS XSC-31</b>	SHEET 510 OF 577